

AUG 05 1994

COMMISSION

LAND CORNER RECORDATION CERTIFICATE
Filing Requirement of Act 74, Mich. P.A. 1970

For corners in
Baraga
(County)

Located In:

Corner Code ##

- | | | |
|------------------------------------|---------------------------|------------|
| 1. Public Land Survey | T <u>50N</u> R <u>34W</u> | <u>F-1</u> |
| | T _____ R _____ | _____ |
| | T _____ R _____ | _____ |
| | T _____ R _____ | _____ |
| 2. Property Controlling in Section | S _____ T _____ R _____ | _____ |
| | S _____ T _____ R _____ | _____ |
| 3. Miscellaneous Property in Sec. | S _____ T _____ R _____ | _____ |
| | S _____ T _____ R _____ | _____ |

RECEIVED FOR RECORD THIS 2ND DAY OF AUGUST, A.D. 1994 AT 9:00 A.M. AI RECORDED IN LIBER 4 OF LAND CORNER RECORDATION ON PAGE 496.

Hilda J. Schillard
 BARAGA COUNTY REGISTER OF DEEDS
 Register of Deeds Stamp & File Number

4. Lot No. _____, Recorded Plat _____
 5. Private Claims _____

I, Dennis R. Destrampe, in a field survey on December 17, 1993, do hereby certify that under requirements of P.A. 74, Michigan P.A. of 1970, the corner points mentioned in lines 1 and 2 above were in conformance with regulations and rules therefore as required in the current manual of survey instructions of the United States Department of the Interior, Bureau of Land Management or by a decree of a Court of Law and/or that the corner points mentioned in lines 3, 4 and 5 above were in conformance with the rules of the Michigan Board of Land Surveyors or by a Decree of a Court of Law; established, re-established, monumented, re-monumented, recovered, found as expressed below:

NOTE: Not more than 4 corners, all in the same town and range, may be recorded on this certificate.

A. Description of original monument and accessories and/or subsequent restoration:

Corner not set in original survey. No record found of being set.


B. Description of corner evidence found and/or method applied in restoring or reestablishing corner:

No corner evidence found. Traverse was run from the NE corner of Section 4 to the NW corner of Section 4; quarter corner was set at mid point.

A	B	C	D	E	F	G	H	I	J	K	L	M
2	6	5	4	3	2	1						
3												
4	7	8	9	10	11	12						
5												
6	18	17	16	15	14	13						
7												
8	19	20	21	22	23	24						
9												
10	30	29	28	27	26	25						
11												
12	31	32	33	34	35	36						
13												

APPROVED LAND CORNER
 P.A. 345 OF 1990
 Baraga County

DR
12-1-93

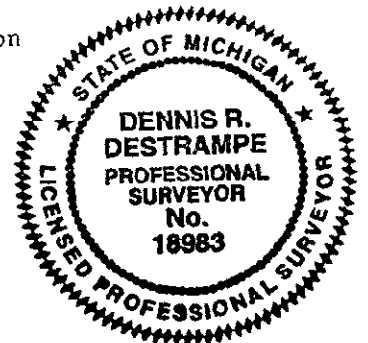

C. Description of monument for corner and accessories established to perpetuate locating the position of the corner:

Set 1"X36" pipe with 2½" brass cap 0.5 feet below grade in gravel road. Baraga Cty Remonumentation brass cap stamped:

Witnesses:

- 9" Aspen S24E 57.81' (Nail & tag "UPEA 18983" set)
- 6" Aspen S07E 38.54' (Nail & tag "UPEA 18983" set)
- 5" Apple S20W 88.78' (Nail & tag "UPEA 18983" set)
- 7" Apple S53W 72.49' (Nail & tag "UPEA 18983" set)

1993
 T51N R34W
 S36
 ●
 1/4 S4
 T50N R34W
 C.C.

Signed by Dennis R. Destrampe
 Surveyor's Michigan License No. 18983

Date May 17, 1994