

**SURVEY & REMONUMENTATION**

AUG 05 1994

**COMMISSION**

**LAND CORNER RECORDATION CERTIFICATE**

**Filing Requirement of Act 74, Mich. P.A. 1970**

For corners in

|                                    |                         |               |
|------------------------------------|-------------------------|---------------|
| Baraga<br>(County)                 | Located In:             | Corner Code # |
| 1. Public Land Survey              | T 50N R 34W             | G-1           |
|                                    | T _____ R _____         | _____         |
|                                    | T _____ R _____         | _____         |
| 2. Property Controlling in Section | S _____ T _____ R _____ | _____         |
|                                    | S _____ T _____ R _____ | _____         |
| 3. Miscellaneous Property in Sec.  | S _____ T _____ R _____ | _____         |
|                                    | S _____ T _____ R _____ | _____         |

RECEIVED FOR RECORD THIS 2ND DAY OF AUGUST, A.D. 1994 AT 9:00 A.M. A RECORDED IN LIBER 4 OF LAND CORNER RECORDATION ON PAGE 497.

*Hilda J. Lehilland*

BARAGA COUNTY REGISTER OF DEEDS

Register of Deeds Stamp & File Number

4. Lot No. \_\_\_\_\_, Recorded Plat \_\_\_\_\_  
 5. Private Claims \_\_\_\_\_

I, Dennis R. Destrampe in a field survey on December 17, 1993, do hereby certify that under requirements of P.A. 74, Michigan P.A. of 1970, the corner points mentioned in lines 1 and 2 above were in conformance with regulations and rules therefore as required in the current manual of survey instructions of the United States Department of the Interior, Bureau of Land Management or by a decree of a Court of Law and/or that the corner points mentioned in lines 3, 4 and 5 above were in conformance with the rules of the Michigan Board of Land Surveyors or by a Decree of a Court of Law; established, re-established, monumented, re-monumented, recovered, found as expressed below:

**NOTE: Not more than 4 corners, all in the same town and range, may be recorded on this certificate.**

|    |    |    |    |    |    |    |   |   |   |   |   |   |   |
|----|----|----|----|----|----|----|---|---|---|---|---|---|---|
|    | A  | B  | C  | D  | E  | F  | G | H | I | J | K | L | M |
| 2  | 6  | 5  | 4  | 3  | 2  | 1  |   |   |   |   |   |   |   |
| 3  |    |    |    |    |    |    |   |   |   |   |   |   |   |
| 4  | 7  | 8  | 9  | 10 | 11 | 12 |   |   |   |   |   |   |   |
| 5  |    |    |    |    |    |    |   |   |   |   |   |   |   |
| 6  | 18 | 17 | 16 | 15 | 14 | 13 |   |   |   |   |   |   |   |
| 7  |    |    |    |    |    |    |   |   |   |   |   |   |   |
| 8  | 19 | 20 | 21 | 22 | 23 | 24 |   |   |   |   |   |   |   |
| 9  |    |    |    |    |    |    |   |   |   |   |   |   |   |
| 10 | 30 | 29 | 28 | 27 | 26 | 25 |   |   |   |   |   |   |   |
| 11 |    |    |    |    |    |    |   |   |   |   |   |   |   |
| 12 | 31 | 32 | 33 | 34 | 35 | 36 |   |   |   |   |   |   |   |


A. Description of original monument and accessories and/or subsequent restoration:

Sugar Post  
 Hemlock 30 S48W 34  
 Lynn 20 S34E 18

Original corner not found. 3/4" iron pin found 4/10/73, recorded 11/17/76, Liber 1, Page 270, Land Corner Recordation, by A.O. Enger, RLS 13581

B. Description of corner evidence found and/or method applied in restoring or reestablishing corner:

3/4" iron pin not found, probably lost in road reconstruction. Found P.K. nail in pavement, verified by 2 remaining witnesses set by A.O. Enger. Corner position accepted as found.

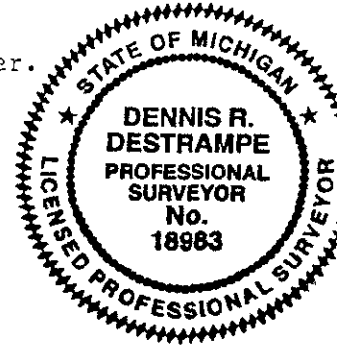

APPROVED LAND CORNER  
 P.A. 345 OF 1990  
 Baraga County

*D.R.D.*  
12-1-93

C. Description of monument for corner and accessories established to perpetuate locating the position of the corner:

Set 1"X36" pipe with 2 1/2" brass cap in monument box 1 foot north of the centerline of Mansfeldt Road. Baraga Cty. Remonumentation brass cap stamped:

Witnesses:

- 15" Maple N70E 77.43' (Nail & tag "UPEA 18983" set)
- Power Pole S50W 46.24' (Nail & tag "UPEA 18983" set)
- 14" W. Pine S62W 76.88' (Nail & tag "UPEA 18983" set)
- 26" Maple N72W 70.48' (Nail & tag "UPEA 18983" set)
- R.R. Spike N19W 4.79'

T51N R34W  
 S36  
 S4 | S3  
 T50N R34W  
 CC  
 1994

Signed by Dennis R. Destrampe

Date June 27, 1994

Surveyor's Michigan License No. 18983