SURVEY & REMONUMENTATION

AUG 0 5 1994

COMMISSION

LAND CORNER RECORDATION CERTIFICATE

Filing Requirement of Act 74, Mich. P.A. 1970

For corners in Baraga (County)

	Located In:	Corner Code #
1. Public Land Survey	T 50N R 34W	H-1
	T ___ R ___	
	T ___ R ___	
	T ___ R ___	
2. Property Controlling	S ___ T ___ R ___	
in Section	S ___ T ___ R ___	
3. Miscellaneous	S ___ T ___ R ___	
Property in Sec.	S ___ T ___ R ___	

RECEIVED FOR RECORD THIS 2ND DAY OF AUGUST, A.D. 1994 AT 9:00 A.M. AI RECORDED IN LIBER 4 OF LAND CORNER RECORDATION ON PAGE 495.

Nellie J. Robillard

BARAGA COUNTY REGISTER OF DEEDS

Register of Deeds Stamp & File Number

4. Lot No. _____, Recorded Plat _____
5. Private Claims _____

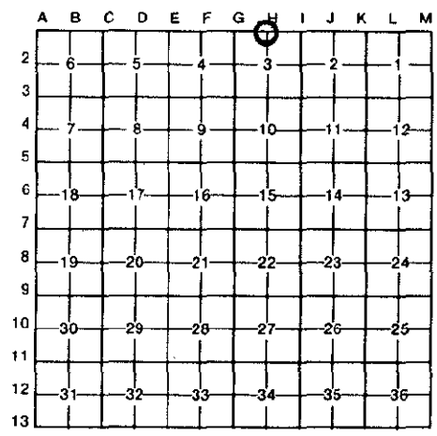

I, Dennis R. Destrampe, in a field survey on December 17, 19 93, do hereby certify that under requirements of P.A. 74, Michigan P.A. of 1970, the corner points mentioned in lines 1 and 2 above were in conformance with regulations and rules therefore as required in the current manual of survey instructions of the United States Department of the Interior, Bureau of Land Management or by a decree of a Court of Law and/or that the corner points mentioned in lines 3, 4 and 5 above were in conformance with the rules of the Michigan Board of Land Surveyors or by a Decree of a Court of Law; established, re-established, monumented, re-monumented, recovered, found as expressed below:

NOTE: Not more than 4 corners, all in the same town and range, may be recorded on this certificate.

A. Description of original monument and accessories and/or subsequent restoration:

Corner not set in original survey. No record found of being set.

B. Description of corner evidence found and/or method applied in restoring or reestablishing corner:

No evidence of corner found. Traverse was run from the NW corner of Section 3 to the NE corner of Section 3. Corner was set at midpoint.

APPROVED LAND CORNER
P.A. 345 OF 1990
Baraga County
KL
12-1-93

STATE OF MICHIGAN
DENNIS R. DESTRAMPE
PROFESSIONAL SURVEYOR
No. 18983
LICENSED PROFESSIONAL SURVEYOR

C. Description of monument for corner and accessories established to perpetuate locating the position of the corner:

Set 1"X36" pipe with 2½" brass cap 6" above ground. Baraga Cty. Remonumentation brass cap stamped:

T51N R33W
1/4 S3
T50N R34W
1994

Witnesses:

NW face	13" Red Maple	N41E	18.60'	(Nail & tag "UPEA 18983" set)
N face	13" Hemlock	S64W	34.64'	(Nail & tag "UPEA 18983" set)
S face	12" Hemlock	N61W	22.83'	(Nail & tag "UPEA 18983" set)
E face	5" Sugar Maple	North	38.42'	(Nail & tag "UPEA 18983" set)

All of the above new bearing trees are scribed "NBT".

Signed by Dennis R. Destrampe Date June 23, 1994

Surveyor's Michigan License No. 18983

FORM APPROVED BY MICHIGAN STATE BOARD OF LAND SURVEYORS, JAN. 28, 1971
REVISED MAY 14, 1975
REVISED JAN., 1983