

AUG 05 1994

COMMISSION

LAND CORNER RECORDATION CERTIFICATE

Filing Requirement of Act 74, Mich. P.A. 1970

For corners in

Baraga

(County)

Located In:

Corner Code #

1. Public Land Survey

T 50N R 34W

K-1

T R

T R

T R

2. Property Controlling in Section

S T R

S T R

3. Miscellaneous Property in Sec.

S T R

S T R

RECEIVED FOR RECORD THIS 2ND DAY OF AUGUST, A.D. 1994 AT 9:00 A.M. AT RECORDED IN LIBER 4 OF LAND CORNER RECORDATION ON PAGE 492.

Della J. Schilke

BARAGA COUNTY REGISTER OF DEEDS

Register of Deeds Stamp & File Number

4. Lot No. _____, Recorded Plat _____

5. Private Claims _____

	A	B	C	D	E	F	G	H	I	J	K	L	M
2	6	5	4	3	2	1							
3													
4	7	8	9	10	11	12							
5													
6	18	17	16	15	14	13							
7													
8	19	20	21	22	23	24							
9													
10	30	29	28	27	26	25							
11													
12	31	32	33	34	35	36							
13													

I, Dennis R. Destrampe, in a field survey on December 17, 1993, do hereby certify that under requirements of P.A. 74, Michigan P.A. of 1970, the corner points mentioned in lines 1 and 2 above were in conformance with regulations and rules therefore as required in the current manual of survey instructions of the United States Department of the Interior, Bureau of Land Management or by a decree of a Court of Law and/or that the corner points mentioned in lines 3, 4 and 5 above were in conformance with the rules of the Michigan Board of Land Surveyors or by a Decree of a Court of Law; established, re-established, monumented, re-monumented, recovered, found as expressed below:

NOTE: Not more than 4 corners, all in the same town and range, may be recorded on this certificate.


A. Description of original monument and accessories and/or subsequent restoration:

Cedar Post
Y Birch 12 S32 $\frac{1}{2}$ W 21
Hemlock 8 S26E 36

Original corner not found. Re-established 4/23/76, recorded Liber 1, Page 271, Land Corner Recordation.

B. Description of corner evidence found and/or method applied in restoring or reestablishing corner:

Found monument box with a 5/8" iron pin with yellow plastic cap marked "MDOT 21583", in Wadaga Road. Fits well with corners to east and west. Four MDOT witnesses were found.

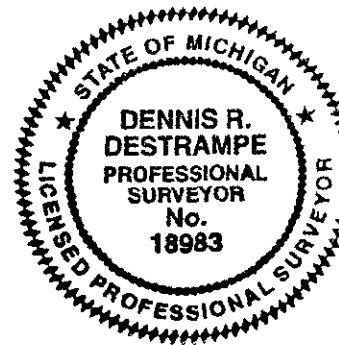

APPROVED LAND CORNER
P.A. 345 OF 1990
Baraga County

Dennis R. Destrampe
12-1-93

C. Description of monument for corner and accessories established to perpetuate locating the position of the corner:

Corner accepted as found.

Witnesses:

NW face 22" Hemlock N59E 56.53' (MDOT tag & nail found)
SW face Power Pole S74E 144.03' (MDOT tag & nail found)
N face 6" Red Maple N50W 50.31' (MDOT tag & nail found)
E face 5" Hemlock N03W 23.15' (MDOT tag & nail found)

Signed by Dennis R. Destrampe Date June 22, 1994
Surveyor's Michigan License No. 18983