

LAND CORNER RECORDATION CERTIFICATE
Filing Requirement of Act 74, Mich. P.A. 1970

For corners in

Baraga

(County)

Located in:

Corner Code #

1. Public Land Survey

T 50N R 34W F11
 T 50N R 34W G10

2. Property Controlling in Section

S ___ T ___ R ___
 S ___ T ___ R ___

3. Miscellaneous Property in Sec.

S ___ T ___ R ___
 S ___ T ___ R ___

Register of Deeds Stamp & File Number

4. Lot No. _____, Recorded Plat _____

5. Private Claims _____

Apr 29 2003

I, Stephan J. Szyszkoski, in a field survey on _____, 20__ do hereby state that under requirements of P.A. 74, Michigan P.A. of 1970, the corner points mentioned in lines 1 and 2 above were in conformance with regulations and rules therefore as required in the current manual of survey instructions of the United States Department of the Interior, Bureau of Land Management or by a decree of a Court of Law and /or that the corner points mentioned in lines 3, 4 and 5 above were in conformance with the rules of the Michigan Board of Land Surveyors or by a Decree of a Court of Law; established, re-established, monumented, recovered, found as expressed below:

NOTE: Not more than 2 corners, all in the same town and range, may be recorded on this certificate.

A	B	C	D	E	F	G	H	I	J	K	L	M
1												
2	6		5		4		3		2		1	
3												
4	7		8		9		10		11		12	
5												
6	18		17		16		15		14		13	
7												
8	19		20		21		22		23		24	
9												
10	30		29		28		27		26		25	
11												
12	31		32		33		34		35		36	
13												

A. Description of original monument and accessories and/or subsequent restoration:


(F11) Quarter corner common to Sections 28 & 33. 1849: Established by Wm. Burt: West corrected...40.25 Set sugar qr Section post. Hemlock 12 N30E 8, Hemlock 10 S40W 33...80.50 Section corner. 1854: Examinations by A.B.Mood: N89deg. 43'E between Sections 28 & 33..40.17 Intersected 12 lks north of post. Hemlock 12 N24E 18, Hemlock 10 S37W 32...80.41 intersected 12 links north of post.
 (G10) Quarter corner common to Sections 27 & 28. 1849: Established by Wm. Burt: North between Sections 27 & 28...40.00 Set Y Birch qr. Section post. Hemlock 30 N20W 9, Hemlock 12 S58E 18...80.00 Set Hemlock post corner of Sections 21,22,27,28.

B. Description of corner evidence found and/or method applied in restoring or reestablishing corner:

(F11) The original post and accessories were not recovered. Reestablished the corner midway and on a line of mean true bearing between Section corners 2661.07' (40.32 ch.) east and west.
 (G10) The original post was not recovered. Remonumented the corner at record bearing and distance from the remains of the two 1849 BT's recovered as follows: 1) Found living Hemlock 30" S54E 18 links with open 8H face blaze, approx. 8" deep with penciled names N.T.Thompson 12/10/43, FJ H__reich, and Roy_er 3/10/54. This face blaze appears to be growth over an older blaze, which was left unopened. 2) Found rotted Hemlock stump N14W 9 links with no markings. Distances north and south to adjacent section corners were determined to be 2617.30' and 2634.39', respectively, this monument being 3.1' west of a true line between them.

C. Description of monument for corner and accessories established to perpetuate locating the position of the corner:

(F11) Set 1"IDx32" I.pipe with 4" alum. MDNR cap. Blazed, scribed, and set measuring nails in: 10" Hemlock N69E 27.7' "1/4S NBT" 9" Hemlock S58E 19.2' do 6" Sugar S79W 9.2' do 5" Sugar N51W 5.3' do Set sq'd sugar post adjacent. Bearings are magnetic. Distances are to nail with tag.	(G10) Set 1"IDx32" I.pipe with 4" alum. MDNR cap. Blazed, scribed, and set measuring nails in: 30" Hemlock (OBT) S54E 11.9' old blaze 6" Sugar N37E 14.3' "1/4S NBT" 15" Sugar S29W 19.7' do 9" Hemlock N86W 13.0' do Set sq'd sugar post adjacent. Bearings are magnetic. Distances are to nail with tag.
---	--

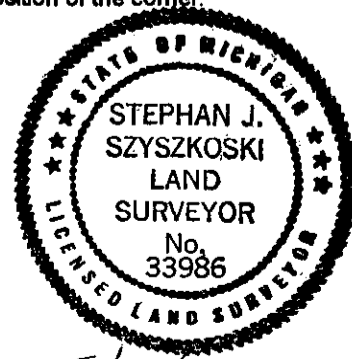

Signed by Stephan J. Szyszkoski
 Surveyor's Michigan License No. 33986

Date 5/22/03