

LAND CORNER RECORDATION CERTIFICATE
Filing Requirement of Act 74, Mich. P.A. 1970

For corners in

Baraga

(County)

Located In:

Corner Code #

1. Public Land Survey	T 50N R 34W	I13
	T 50N R 34W	G11
	T _____ R _____	_____
	T _____ R _____	_____
2. Property Controlling in Section	S _____ T _____ R _____	_____
	S _____ T _____ R _____	_____
3. Miscellaneous Property in Sec.	S _____ T _____ R _____	_____
	S _____ T _____ R _____	_____

Register of Deeds Stamp & File Number

4. Lot No. _____, Recorded Plat _____
 5. Private Claims _____

May 13 2003

I, Stephan J. Szyszkoski, in a field survey on _____, 20____ do hereby state that under requirements of P.A. 74, Michigan P.A. of 1970, the corner points mentioned in lines 1 and 2 above were in conformance with regulations and rules therefore as required in the current manual of survey instructions of the United States Department of the Interior, Bureau of Land Management or by a decree of a Court of Law and /or that the corner points mentioned in lines 3, 4 and 5 above were in conformance with the rules of the Michigan Board of Land Surveyors or by a Decree of a Court of Law; established, re-established, monumented, recovered, found as expressed below:

NOTE: Not more than 2 corners, all in the same town and range, may be recorded on this certificate.

A	B	C	D	E	F	G	H	I	J	K	L	M
1												
2	6		5		4		3		2		1	
3												
4	7		8		9		10		11		12	
5												
6	10		17		16		15		14		13	
7												
8	19		20		21		22		23		24	
9												
10	30		29		28		27		26		25	
11												
12	31		32		33		34		35		36	
13												

A. Description of original monument and accessories and/or subsequent restoration:

(I13) Corner common to Sections 34 & 35 T50N-R34W and 2 & 3 T49N-R34W. 1958: Remonumented by Billy D. Buckler RLS: Set corner on E-W fence line and in line with fence to north. Checked distance south 2 miles and west 1 mile. Find these distances correct. Corner lies 15 links west of woods road. Found old blazes in vicinity. Set 1" pipe with 4" brass cap. 12" W.Pine N45E 62 links, 8" Hard Maple S21W 48 links, 9" Y.Birch N37W 31 links.

(G11) Corner common to Sections 27-28-33-34. 1961: Remonumented by Billy D. Buckler RLS, in the original position from remains of Hemlock OBT. Set 1" pipe with 4" aluminum cap. 9" Soft Maple S66E 42.5 links, 14" Soft Maple S18W 79 links, 16" Hemlock N85W 75 links.

B. Description of corner evidence found and/or method applied in restoring or reestablishing corner:


(I13) Recovered the 1958 monument at record bearing and distance from the record NBTs. The W.Pine and Y.Birch are now rotting stumps. The Sugar, now 11" DBH, shows double overgrown blazes. Left the monument in place and made new witnesses as described below. A scribed 4x4 post was found adjacent.

(G11) Recovered the 1961 monument in good condition and at record bearing and distance from the three 1961 NBTs, all with old blazes evident. The Soft Maple SW is now a stump. The other two are in good condition and are further described below. Left the monument in place and made two new NBTs.

C. Description of monument for corner and accessories established to perpetuate locating the position of the corner:

(I13) Found 1" ID I. pipe with 4" brass State of Michigan cap. Blazed, scribed, and set measuring nails in:
 8" Sugar N67E 29.6' "S35 NBT"
 14" Oak N69W 16.1' "S34 NBT"
 6" Sugar North 3.2' "S34 NBT"
 Made no new blazes on the 1958 Sugar:
 11" Sugar S22W 31.5'
 Bearings are magnetic. Distances are to nail with tag.

(G11) Found 1" ID I. pipe with 4" aluminum State of Michigan cap. Blazed, scribed, and set measuring nails in:
 10" Sugar S32E 16.65' "S34 NBT"
 6" Sugar N19W 8.8' "S28 NBT"
 Made no new blazes on the 1961 NBTs:
 14" Maple S61E 28.1'
 19" Hemlock N77W 49.9'
 Set a sq'd cedar post adjacent.
 Bearings are magnetic. Distances are to nail with tag.

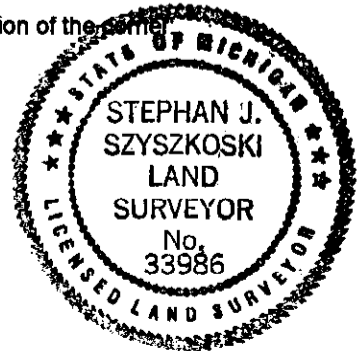

Signed by Stephan J. Szyszkoski
 Surveyor's Michigan License No. 33986

Date 5/22/03