LAND CORNER RECORDATION CERTIFICATE
Filing Requirement of Act 74, Mich. P.A. 1970 as Amended

For corners in

Baraga
(County)

		Located In:	Corner Code #
1. Public Land Survey		T 50N R 34W	K3
		T 50N R 34W	J3
		T R	
	S	T R	
2. Property Controlling	S	T R	
in Section	S	T R	
3. Miscellaneous	S	T R	
Property in Sec.	S	T R	

Register of Deeds Stamp & File Number

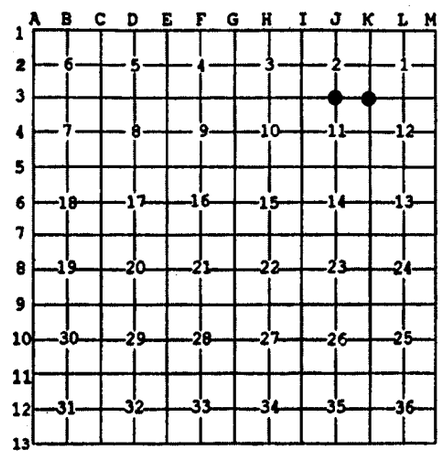

4. Lot No. _____ , Recorded Plat_____
5. Private Claims

I, Stephan J. Szyszkoski, in a field survey on Aug 30 2006, 20 ____ do hereby state that under requirements of P.A. 74, Michigan P.A. of 1970, the corner points mentioned in lines 1 and 2 above were in conformance with regulations and rules therefore as required in the current manual of survey instructions of the United States Department of the Interior, Bureau of Land Management or by a decree of a Court of Law and /or that the corner points mentioned in lines 3, 4 and 5 above were in conformance with the rules of the Michigan Board of Land Surveyors or by a Decree of a Court of Law; established, re-established, monumented, recovered, found as expressed below:

NOTE: Not more than 2 corners, all in the same town and range, may be recorded on this certificate.

A. Description of original monument and accessories and/or subsequent restoration:

(K3) Corner previously reestablished by K.L.Sackett RLS in 1977 by reference to land calls north, south, east, and west, and to section corner to north. Set 1"IDx36" iron pipe with 4" aluminum MDNR cap. 9" Cedar S60E 11.1', 4" Cedar N02E 11.3', 7" Cedar S45W 21.0'. Circa 1988 - The 1977 monument was located and accepted by R.W.Crampton RLS who made measurements to it from traverse points along the railroad to the east of K3.
(J3) Quarter corner common to Sections 2 and 11. 1849 - Established by Wm. Burt, Deputy Surveyor midway and on line between Section corners 39.71 chains east and west. Hemlock 12 for Quarter Section corner. Bearing tree: Hemlock 12 N12E 27 links.

B. Description of corner evidence found and/or method applied in restoring or reestablishing corner:

(K3) The 1977 monument was not located. A thorough search at the corner position with a metal detector revealed no trace of ferrous metal. Recovered the 1977 NBT N02E, now standing dead and the 1977 NBT S45W also standing dead but not accessible due to its location in the backwater of the old dam. The NBT SE was found dead and down in the mud. Reestablished the position for the corner at the 1977 position by record bearing and distance from the 1977 NBT N02E and Mr. Crampton's record measurements from his 1988 traverse points, which were found along the railroad in good condition. The position for the corner falls in an old beaver dam and is not accessible for monumentation. Set a Witness corner 17.00' north of the reestablished corner position.
(J3) The original corner and bearing trees were not recovered. Found no evidence of the position of the original corner on the ground. Reestablished the corner midway and on the section line between Section corners 2635.24' east and west.

C. Description of monument for corner and accessories established to perpetuate locating the position of the corner:

(K3) Set 1"IDx32" I.pipe with 4" alum. MDNR cap for a Witness Corner on the Section line 17.00' north of the corner position. Set measuring nails in:
7" Cedar stump S04E 5.15' mrkd "WC BT"
6" Cedar, dead S83E 28.8' do
8" Cedar, dead N11E 11.9' do
Sq'd cedar post North 0.85' to center. Bearings are magnetic. Distances to trees are to nail with tag.

(J3) Set 1"IDx32" I.pipe with 4" alum. MDNR cap. Set measuring nails in:
4" Sugar N15E 19.4' mrkd "1/4S NBT"
9" Maple N67E 22.6' do
7" Maple S07E 13.6' do
9" twin Maple S78W 12.3' do
Set sq'd cedar post adjacent. Bearings are magnetic. Distances are to nail with tag.

STATE OF MICHIGAN
STEPHAN J. SZYSZKOSKI
LAND SURVEYOR
No. 33986
LICENSED LAND SURVEYOR

Signed by Stephan J. Szyszkoski Date 10/24/06

Surveyor's Michigan License No. 33986

For the Michigan Department of Natural Resources, Office of Land and Facilities

FORM APPROVED BY MICHIGAN STATE BOARD OF PROFESSIONAL SURVEYORS, JAN. 28, 1971
Revised May 14, 1975
Revised Jan., 1983
Revised Oct., 1995