LAND CORNER RECORDATION CERTIFICATE
Filing Requirement of Act 74, Mich. P.A. 1970 as Amended

For corners in

Baraga (County) Located In: Corner Code #

1. Public Land Survey		T___	R___	
		T___	R___	
		T___	R___	
	S___	T___	R___	
2. Property Controlling	S 16	T 50N	R 34W	6
in Section	S 16	T 50N	R 34W	5
3. Miscellaneous	S___	T___	R___	
Property in Sec.	S___	T___	R___	

Register of Deeds Stamp & File Number

4. Lot No. _____, Recorded Plat_____
5. Private Claims

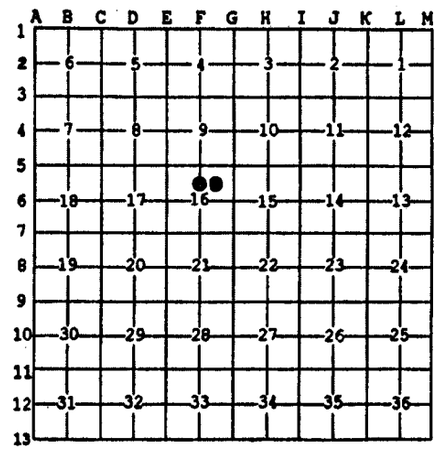

Jul 17 2006

I, Stephan J. Szyszkoski, in a field survey on _____, 20 ____ do hereby state that under requirements of P.A. 74, Michigan P.A. of 1970, the corner points mentioned in lines 1 and 2 above were in conformance with regulations and rules therefore as required in the current manual of survey instructions of the United States Department of the Interior, Bureau of Land Management or by a decree of a Court of Law and /or that the corner points mentioned in lines 3, 4 and 5 above were in conformance with the rules of the Michigan Board of Land Surveyors or by a Decree of a Court of Law; established, re-established, monumented, recovered, found as expressed below:

NOTE: Not more than 2 corners, all in the same town and range, may be recorded on this certificate.

A. Description of original monument and accessories and/or subsequent restoration:

(6-Sec. 16) Northeast 1/16 corner. Not established in the original survey.
(5-Sec. 16) North 1/16 corner, Section 16. Not established in the original survey.

B. Description of corner evidence found and/or method applied in restoring or reestablishing corner:

(6-Sec. 16) Established the corner at the intersection of straight lines connecting opposite 1/16 corners.
(5-Sec. 16) Established the corner midway and on a straight line between Quarter corner common to Sections 9 & 16 and the intersection of quarter lines of Section 16.

C. Description of monument for corner and accessories established to perpetuate locating the position of the corner:

(6) Set 1"IDx32" I.pipe with 4" alum. MDNR cap. Set measuring nails in:
8" Poplar N07E 1.4' mrkd "1/16S BT"
6" R.Pine S39E 11.8' do
18" R.Pine S38W 9.4' do
17" R.Pine N89W 29.2' do
Set sq'd cedar post adjacent. Bearings are magnetic. Distances are to nail with tag.

(5) Set 1"IDx32" I.pipe with 4" alum. MDNR cap. Set measuring nails in:
13" W.Pine N27E 33.0' mrkd "1/16S BT"
14" dbl. R.Pine S75E 9.4' do
13" R.Pine S42W 14.9' do
12" R.Pine N51W 18.2' do
Set sq'd cedar post adjacent. Bearings are magnetic. Distances are to nail with tag.

STATE OF MICHIGAN
STEPHAN J. SZYSZKOSKI
LAND SURVEYOR
No. 33986
LICENSED LAND SURVEYOR

Signed by Stephan J. Szyszkoski Date 10/24/06

Surveyor's Michigan License No. 33986

For the Michigan Department of Natural Resources, Office of Land and Facilities

FORM APPROVED BY MICHIGAN STATE BOARD OF PROFESSIONAL SURVEYORS, JAN. 28, 1971
Revised May 14, 1975
Revised Jan., 1983
Rervised Oct., 1995