

SURVEY &  
REMONUMENTATION  
MAY 17 1994  
COMMISSION

**LAND CORNER RECORDATION CERTIFICATE**  
Filing Requirement of Act 74, Mich. P.A. 1970

For corners in

Baraga	Located In:	Corner Code #/
(County)		
1. Public Land Survey	T <u>50N</u> R <u>35W</u>	<u>G-1</u>
	T _____ R _____	_____
	T _____ R _____	_____
	T _____ R _____	_____
2. Property Controlling in Section	S _____ T _____ R _____	_____
	S _____ T _____ R _____	_____
3. Miscellaneous Property in Sec.	S _____ T _____ R _____	_____
	S _____ T _____ R _____	_____
4. Lot No. _____, Recorded Plat _____		
5. Private Claims _____		

RECEIVED FOR RECORD THIS 30TH DAY  
OF DECEMBER A. D. 1993 AT 10:30  
A. M. AND RECORDED IN LIBER 4 OF  
LAND CORNER RECORDATION ON PAGE  
475.

*Hubert J. Robillard*  
BARAGA COUNTY REGISTER OF DEEDS  
Register of Deeds Stamp & File Number

I, Dennis R. Destrampe, in a field survey on December 9, 1993,  
do hereby certify that under requirements of P.A. 74, Michigan P.A. of 1970, the corner points mentioned  
in lines 1 and 2 above were in conformance with regulations and rules therefore as required in the  
current manual of survey instructions of the United States Department of the Interior, Bureau of Land  
Management or by a decree of a Court of Law and/or that the corner points mentioned in lines 3, 4 and 5  
above were in conformance with the rules of the Michigan Board of Land Surveyors or by a Decree of a  
Court of Law; established, re-established, monumented, re-monumented, recovered, found as  
expressed below:

	A	B	C	D	E	F	G	H	I	J	K	L	M
2	6	5	4	3	2	1							
3													
4	7	8	9	10	11	12							
5													
6	18	17	16	15	14	13							
7													
8	19	20	21	22	23	24							
9													
10	30	29	28	27	26	25							
11													
12	31	32	33	34	35	36							
13													


**NOTE: Not more than 4 corners, all in the same town and range, may be recorded on this certificate.**

A. Description of original monument and accessories and/or subsequent restoration:  
Wood Post Original corner not found. Corner was restored October 31, 1961  
Hemlock 12 S45E 16 and recorded April 13, 1964, Book 2, Index A-13, Page 11  
Maple 10 S30W 21

B. Description of corner evidence found and/or method applied in restoring or reestablishing corner:  
Corner found as described in Book 2, Index A-13, Page 11:  
  
2" pipe with 3" bronze tablet which reads: T. 50-51 N.; R. 34-35 W.;  
S-31, S-3, S-4; C.C.; 1961

C. Description of monument for corner and accessories established to perpetuate locating the position of the corner:  
Corner accepted as found

Witnesses: 12" Maple S57E 38.25' (8d nail found)  
9" Maple S24W 26.13' (8d nail found)  
9" Maple S75W 40.27' (8d nail found)  
10" Maple N22W 11.95' (Nail & tag "UPEA 18983" set)

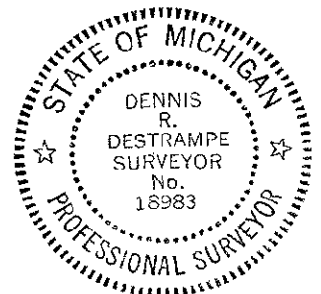

Signed by Dennis R. Destrampe Date December 22, 1993  
Surveyor's Michigan License No. 18983