

MAY 17 1994

COMMISSION

LAND CORNER RECORDATION CERTIFICATE

Filing Requirement of Act 74, Mich. P.A. 1970

For corners in

Baraga

(County)

Located In:

Corner Code -#

- | | | | | | |
|------------------------------------|---|-----|---|-----|-----|
| 1. Public Land Survey | T | 50N | R | 35W | K-1 |
| | T | | R | | |
| | T | | R | | |
| | T | | R | | |
| 2. Property Controlling in Section | S | | T | R | |
| | S | | T | R | |
| 3. Miscellaneous Property in Sec. | S | | T | R | |
| | S | | T | R | |

RECEIVED FOR RECORD THIS 30TH DAY OF DECEMBER A. D. 1993 AT 10:30 A. M. AND RECORDED IN LIBER 4 OF LAND CORNER RECORDATION ON PAGE 467.

Dennis R. Destrampe
BARAGA COUNTY REGISTER OF DEEDS
Register of Deeds Stamp & File Number

4. Lot No. _____, Recorded Plat _____
5. Private Claims _____

	A	B	C	D	E	F	G	H	I	J	K	L	M
2	6	5	4	3	2	1							
3													
4	7	8	9	10	11	12							
5													
6	18	17	16	15	14	13							
7													
8	19	20	21	22	23	24							
9													
10	30	29	28	27	26	25							
11													
12	31	32	33	34	35	36							
13													


I, Dennis R. Destrampe, in a field survey on December 9, 1993, do hereby certify that under requirements of P.A. 74, Michigan P.A. of 1970, the corner points mentioned in lines 1 and 2 above were in conformance with regulations and rules therefore as required in the current manual of survey instructions of the United States Department of the Interior, Bureau of Land Management or by a decree of a Court of Law and/or that the corner points mentioned in lines 3, 4 and 5 above were in conformance with the rules of the Michigan Board of Land Surveyors or by a Decree of a Court of Law; established, re-established, monumented, re-monumented, recovered, found as expressed below:

NOTE: Not more than 4 corners, all in the same town and range, may be recorded on this certificate.


- A. Description of original monument and accessories and/or subsequent restoration:
 Wood Post Original corner not found. Corner was restored in U.S.F.S.
 Maple 8 S44E 32 survey recorded in Volume 1 of Plats, January 7, 1964.
 Hemlock 12 S58W 27 No L.C.R.C. was found for this corner.

- B. Description of corner evidence found and/or method applied in restoring or reestablishing corner:

Found 2" pipe with 3" brass cap 1.6 feet above ground.
Cap reads:

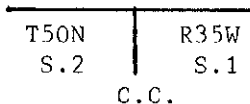

1962 R.L.S. 12585

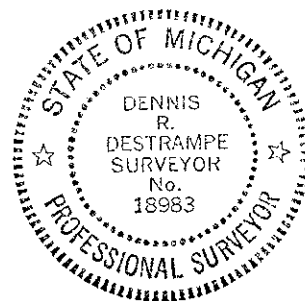

- C. Description of monument for corner and accessories established to perpetuate locating the position of the corner:
Corner accepted as found

Witnesses: 7" Maple N26E 7.64' (Nail & tag "UPEA 18983" set)
 8" Maple S06E 18.11' (Nail & tag "UPEA 18983" set)(USFS BT)
 7" Maple S28W 20.79' (Nail & tag "UPEA 18983" set)
 10" Maple S66W 31.54' (Nail & tag "UPEA 18983" set)(USFS BT)

Signed by Dennis R. Destrampe Date December 27, 1993

Surveyor's Michigan License No. 18983