

MAY 17 1994

COMMISSION

LAND CORNER RECORDATION CERTIFICATE
Filing Requirement of Act 74, Mich. P.A. 1970

For corners in

Baraga

(County)

Located In:

Corner Code #

- | | | | | | |
|------------------------------------|---|-----|---|-----|-----|
| 1. Public Land Survey | T | 50N | R | 35W | M-1 |
| | T | | R | | |
| | T | | R | | |
| | T | | R | | |
| 2. Property Controlling in Section | S | | T | R | |
| | S | | T | R | |
| 3. Miscellaneous Property in Sec. | S | | T | R | |
| | S | | T | R | |
4. Lot No. _____, Recorded Plat _____
5. Private Claims _____

RECEIVED FOR RECORD THIS 30TH DAY OF DECEMBER A. D. 1993 AT 10:30 A. M. AND RECORDED IN LIBER 4 OF LAND CORNER RECORDATION ON PAGE 463.

Hilda J. Rohlfend
BARAGA COUNTY REGISTER OF DEEDS
Register of Deeds Stamp & File Number

	A	B	C	D	E	F	G	H	I	J	K	L	M
2	6	5	4	3	2	1							
3													
4	7	8	9	10	11	12							
5													
6	18	17	16	15	14	13							
7													
8	19	20	21	22	23	24							
9													
10	30	29	28	27	26	25							
11													
12	31	32	33	34	35	36							
13													

I, Dennis R. Destrampe, in a field survey on December 17, 1993, do hereby certify that under requirements of P.A. 74, Michigan P.A. of 1970, the corner points mentioned in lines 1 and 2 above were in conformance with regulations and rules therefore as required in the current manual of survey instructions of the United States Department of the Interior, Bureau of Land Management or by a decree of a Court of Law and/or that the corner points mentioned in lines 3, 4 and 5 above were in conformance with the rules of the Michigan Board of Land Surveyors or by a Decree of a Court of Law; established, re-established, monumented, re-monumented, recovered, found as expressed below:



NOTE: Not more than 4 corners, all in the same town and range, may be recorded on this certificate.

A. Description of original monument and accessories and/or subsequent restoration:

Elm Post	Original corner not found. Corner was restored in U.S.F.S. survey
Elm 12 S73E 9	recorded in Volume 1 of Plats, January 7, 1964. No L.C.R.C. was
Cedar 18 S32W 8	found for this corner.

B. Description of corner evidence found and/or method applied in restoring or reestablishing corner:

Found 2" pipe with 3" brass cap 1.6 feet above ground.
Cap reads: T51N R34W

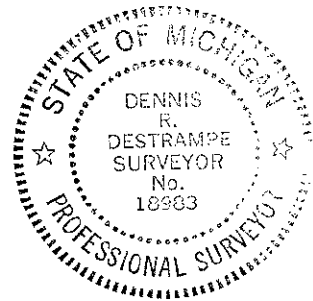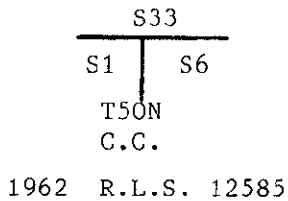

C. Description of monument for corner and accessories established to perpetuate locating the position of the corner:

Corner accepted as found.

Witnesses:	8" Balsam	S58E	33.70'	(Nail & tag "UPEA 18983" set)(USFS BT)
	9" Balsam	S66W	19.62'	(Nail & tag "UPEA 18983" set)(USFS BT)
	14" Balsam	N05W	73.65'	(Nail & tag "UPEA 18983" set)(USFS BT)
	8" Balsam	S87E	48.63'	(Nail & tag "UPEA 18983" set)

Signed by Dennis R. Destrampe Date December 29, 1993
Surveyor's Michigan License No. 18983