

**SURVEY & REMONUMENTATION**

APR 26 1995

**COMMISSION**

**LAND CORNER RECORDATION CERTIFICATE**  
Filing Requirement of Act 74, Mich. P.A. 1970

For corners in

<u>Baraga</u> <small>(County)</small>	Located In:	Corner Code #
	51N 30W	F-13
1. Public Land Survey	T _____ R _____	_____
	T _____ R _____	_____
	T _____ R _____	_____
	T _____ R _____	_____
2. Property Controlling in Section	S _____ T _____ R _____	_____
	S _____ T _____ R _____	_____
3. Miscellaneous Property in Sec.	S _____ T _____ R _____	_____
	S _____ T _____ R _____	_____

RECEIVED FOR RECORD THIS 19TH DAY OF DECEMBER, A.D. 1994 AT 9:00 A.M. AND RECORDED IN LIBER 4 OF LAND CORNER RECORDATION ON PAGES 523-524.

*Arden J. Robillard*  
BARAGA COUNTY REGISTER OF DEEDS

Register of Deeds Stamp & File Number

4. Lot No. \_\_\_\_\_, Recorded Plat \_\_\_\_\_  
5. Private Claims \_\_\_\_\_

A	B	C	D	E	F	G	H	I	J	K	L	M
2	6	5	4	3	2	1						
3												
4	7	8	9	10	11	12						
5												
6	18	17	16	15	14	13						
7												
8	19	20	21	22	23	24						
9												
10	30	29	28	27	26	25						
11												
12	31	32	33	34	35	36						
13												

I, Michael Mileski, in a field survey on December 19 94, do hereby certify that under requirements of P.A. 74, Michigan P.A. of 1970, the corner points mentioned in lines 1 and 2 above were in conformance with regulations and rules therefore as required in the current manual of survey instructions of the United States Department of the Interior, Bureau of Land Management or by a decree of a Court of Law and/or that the corner points mentioned in lines 3, 4 and 5 above were in conformance with the rules of the Michigan Board of Land Surveyors or by a Decree of a Court of Law; established, re-established, monumented, re-monumented, recovered, found as expressed below:


**NOTE: Not more than 4 corners, all in the same town and range, may be recorded on this certificate.**

A. Description of original monument and accessories and/or subsequent restoration:

F-13; South One-quarter Corner Section 33, T51N, R30W, on 5th Correction Line.

See back of form.

APPROVED LAND CORNER  
P.A. 345 OF 1990  
Baraga County  
*[Signature]*  
12-9-94

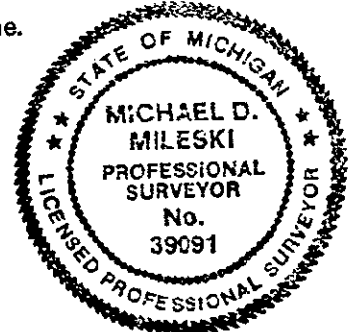

B. Description of corner evidence found and/or method applied in restoring or reestablishing corner:

F-13; South One-quarter Corner Section 33, T51N, R30W, on 5th Correction Line.

Found Mr. Schmeling's 1" x 48" galvanized iron pipe with stamped 4" brass cap projecting 18" above ground to be in agreement with his red maple new bearing tree and Mr. Thompson's hemlock new bearing tree. I did not remonument the corner. Accepted found monument as a careful and faithful perpetuation of the position of the original corner.

C. Description of monument for corner and accessories established to perpetuate locating the position of the corner:

F-13; South One-quarter Corner Section 33, T51N, R30W, on 5th Correction Line.

Found 1" x 48" galvanized iron pipe with stamped 4" brass cap.

Set 60d spike	W/side	5" Sugar Maple	N19°E	24.47'
Set 60d spike	N/side	17" Hemlock	S52°E	13.94'
Set 60d spike	N/side	15" Hemlock	S67°W	7.98'
Set 60d spike	NE/side	11" Red Maple	N32°W	30.32'

All of the above new bearing trees marked with upper and lower face blazes and scribed "NBT".

Signed by *Michael Mileski* Date 19 December 1994

Surveyor's Michigan License No. 39091

A. Description of original monument and accessories and/or subsequent restoration:

F-13; South One-quarter Corner Section 33, T51N, R30W, on 5th Correction Line.

Originally established during U.S. Survey conducted by Austin Burt, D.S. in 1845 and monumented with a wood post witnessed by a

Birch 10 N13°E 29 lks.  
(Recovered as a 16" ± dia. severely decayed stump having no identifiable marks.)

and a

Sugar 8 N36°W 19 lks.  
(Recovered as ground-level remains.)

The late Norman Thompson, RLS #4348 states in his field notes dated 2 August 1945 (copies of which were obtained from the Northern Hardwoods' office in L'Anse) that the northeast (birch) U.S. bearing tree was alive and 20" in diameter. Mr. Thompson set a hemlock post and noted the following new bearing trees:

Hemlock 10 N73°E 5.7'  
(Presently alive and 11" in dia. - Set 60d spike S/side N71°E 5.70')

and a

Yellow Birch 16 N01°E 31.2'  
(Recovered as a 16" dia. severely decayed stump having no discernible marks)

According to a Land Corner Recordation Certificate filed by Robert Schmeling, P.S. #8317 and recorded in Liber 1 on page 163 during the course of a field survey conducted on 12 September 1974 Mr. Schmeling recovered Mr. Thompson's new bearing trees. Mr. Schmeling states that he recovered the birch U.S. bearing tree as a "badly rotted stub 12' high, 20" D.B.H." with scribe marks on the lower face blaze still evident. Mr. Schmeling set a 1" x 48" galvanized iron pipe with 4" brass cap appropriately stamped as to location and noted the following new bearing trees:

White Spruce 12" N06°W 55.3' to CL  
(Found windthrown)

and a

Red Maple 7" N42°E 46.1' to CL  
(Found snapped at mid-trunk.)