

**SURVEY &  
REMONUMENTATION**

APR 26 1995

**COMMISSION**

**LAND CORNER RECORDATION CERTIFICATE  
Filing Requirement of Act 74, Mich. P.A. 1970**

For corners in

<u>Baraga</u> <small>(County)</small>	Located In:	Corner Code #
	51N 30W	I-13
1. Public Land Survey	T _____ R _____	_____
	T _____ R _____	_____
	T _____ R _____	_____
	T _____ R _____	_____
2. Property Controlling in Section	S _____ T _____ R _____	_____
	S _____ T _____ R _____	_____
3. Miscellaneous Property in Sec.	S _____ T _____ R _____	_____
	S _____ T _____ R _____	_____
4. Lot No. _____, Recorded Plat _____		
5. Private Claims _____		

RECEIVED FOR RECORD THIS 19TH DAY  
OF DECEMBER, A.D. 1994 AT 9:00 A.M.  
AND RECORDED IN LIBER 4 OF LAND  
CORNER RECORDATION ON PAGES  
541-542.

*Hilda J. Robillard*

BARAGA COUNTY REGISTER OF DEEDS

Register of Deeds Stamp & File Number

I, Michael Mileski, in a field survey on December 19 94, do hereby certify that under requirements of P.A. 74, Michigan P.A. of 1970, the corner points mentioned in lines 1 and 2 above were in conformance with regulations and rules therefore as required in the current manual of survey instructions of the United States Department of the Interior, Bureau of Land Management or by a decree of a Court of Law and/or that the corner points mentioned in lines 3, 4 and 5 above were in conformance with the rules of the Michigan Board of Land Surveyors or by a Decree of a Court of Law; established, re-established, monumented, re-monumented, recovered, found as expressed below:

**NOTE: Not more than 4 corners, all in the same town and range, may be recorded on this certificate.**

A	B	C	D	E	F	G	H	I	J	K	L	M
2	6	5	4	3	2	1						
3												
4	7	8	9	10	11	12						
5												
6	18	17	16	15	14	13						
7												
8	19	20	21	22	23	24						
9												
10	30	29	28	27	26	25						
11												
12	31	32	33	34	35	36						
13												


A. Description of original monument and accessories and/or subsequent restoration:

I-13; Section Corner common to Sections 34 and 35, T51N, R30W, on 5th Correction Line.

See back of form.

APPROVED LAND CORNER  
P.A. 345 OF 1990  
Baraga County

*Mileski*  
12-9-94

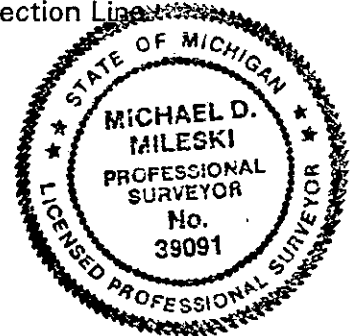

3. Description of corner evidence found and/or method applied in restoring or reestablishing corner:

I-13; Section Corner common to Sections 34 and 35, T51N, R30W, on 5th Correction Line.

Found 1 1/4" (I.D.) iron pipe and spruce post along the west side of a 16" sugar maple having healed squared blazes at breast height in each cardinal direction. This iron pipe is firmly set and not removable. Accepted as a careful and faithful perpetuation of the position of the original corner.

7. Description of monument for corner and accessories established to perpetuate locating the position of the corner:

I-13; Section Corner common to Sections 34 and 35, T51N, R30W, on 5th Correction Line.

Left found iron pipe in place.

Set 60d spike	NW/side	15" Sugar Maple	N62°E	12.80'
Set 60d spike	E/side	11" Sugar Maple	S19°E	16.88'
Set 60d spike	S/side	9" Sugar Maple	S88°W	12.70'
Set 60d spike	W/side	11" Sugar Maple	N05°W	18.28'

All of the above new bearing trees marked with upper and lower face blazes and scribed "NBT".

Signed by Michael Mileski Date 19 December 1994

Surveyor's Michigan License No. 39091

A. Description of original monument and accessories and/or subsequent restoration:

I-13; Section Corner common to Sections 34 and 35, T51N, R30W, on 5th Correction Line.

Originally established during U.S. Survey conducted by Austin Burt, D.S. in 1845 and monumented by an 8" diameter sugar maple witnessed by a

Sugar 9 N22°E 23 lks. (Inconclusive)

The late Norman Thompson, RLS #4348, states in his field notes dated 28 January 1947 (copies of which were obtained from Northern Hardwoods' office in L'Anse) that he found both U.S. bearing trees to be "ok". Mr. Thompson remonumented the corner with a spruce post and on 17 June 1948 he added an iron pipe. Mr. Thompson noted two new bearing trees but the information is not readable from his field notes.