

LAND CORNER RECORDATION CERTIFICATE
Filing Requirement of Act 74, Mich. P.A. 1970 as Amended

For corners in

<u>Baraga</u> (County)	Located In:	Corner Code #
1. Public Land Survey	T 51N R 30W	A1
	T 51N R 30W	E2
	T _____ R _____	_____
2. Property Controlling in Section	S _____ T _____ R _____	_____
	S _____ T _____ R _____	_____
3. Miscellaneous Property in Sec.	S _____ T _____ R _____	_____
	S _____ T _____ R _____	_____

Register of Deeds Stamp & File Number

4. Lot No. _____, Recorded Plat _____
 5. Private Claims
 E2 Jun 16 2005
 A1 Jun 15 2005

I, Stephan J. Szyszkoski, in a field survey on _____, 20____ do hereby state that under requirements of P.A. 74, Michigan P.A. of 1970, the corner points mentioned in lines 1 and 2 above were in conformance with regulations and rules therefore as required in the current manual of survey instructions of the United States Department of the Interior, Bureau of Land Management or by a decree of a Court of Law and /or that the corner points mentioned in lines 3, 4 and 5 above were in conformance with the rules of the Michigan Board of Land Surveyors or by a Decree of a Court of Law; established, re-established, monumented, recovered, found as expressed below:

NOTE: Not more than 2 corners, all in the same town and range, may be recorded on this certificate.

A. Description of original monument and accessories and/or subsequent restoration:


(A1) Corner to townships 51-52N and 30-31W. 1845 - Established by Wm. A. Burt: West on south side of Section 31 T52N-R30W ...80.88 Intersected Range line 115 links south of temporary post and set post. Fir 8 S36E 23, Hemlock 14 N9W 25.
 (E2) Quarter corner common to Sections 4-5. 1965 - Corner reestablished by single proportionate measurement to the original record by F.J.Bray, RLS. Set 1" iron pipe with 4" aluminum cap. 5" S.Maple S73W 17 links, 4" S.Maple S79E 04 links.

B. Description of corner evidence found and/or method applied in restoring or reestablishing corner:

(A1) The original post and accessories were not recovered, likely having been destroyed by the construction of Greenhouse Rd. Found an iron spike set in the center of Greenhouse Rd. at its intersection with old fencelines to the north and south. From the spike, the perpetuation of an original corner at A3 bears S00 deg. 00' 39"W 5193.26' (5204.10' GLO), the perpetuation of an original corner at C1 bears S89 deg. 53'06"E 5301.56' (5338.1' GLO), a reestablished corner at A11 T52N-R30W bears N 00 deg. 35'38"W 5287.47' (5280 GLO), and a found spike (an apparent perpetuation or reestablishment of K13 T52N-R31W, not confirmed by the undersigned) bears N89 deg. 57' 16"W 5309.12' (5280 GLO). Accepted the intersection of the fence lines and road centerline as the best available evidence of the position of the original corner and replaced the spike with a new monument, as described below.
 (E2) Found the 1965 monument in good condition and at record bearing and distance from the 1965 witnesses. The NBT SE is dead and down. The NBT SW is leaning over the corner in good condition but was cut during this survey to facilitate GPS observations. Found the monumented position to be 0.78' north and 0.05' west of the SPM position of record and accepted same as a careful and faithful reestablishment of the position of the original corner.

C. Description of monument for corner and accessories established to perpetuate locating the position of the corner:

(A1) Set 1"IDx32" I.pipe with 4" alum. MDNR cap, buried 6" below rd. surface. Set measuring nails in: 7" Spruce N44W 31.9' mrkd "S36 NBT" 8" Maple N62E 42.3' "S31 NBT" 10" W.Pine S56E 49.4' "S6 NBT" 5" Spruce S15E 16.3' "S6 NBT" Bearings are magnetic. Distances are to nail with tag.	(E2) Found 1"ID I.pipe with 4" alum. MDNR cap. Set measuring nails in: 10" W.Spruce N41E 30.0' mrkd "1/4S NBT" 5" Sugar S29E 21.2' do 6" Maple S65W 18.3' do 4" Maple N77W 20.9' do Set sq'd cedar post adjacent. Bearings are magnetic. Distances are to nail with tag.
---	--

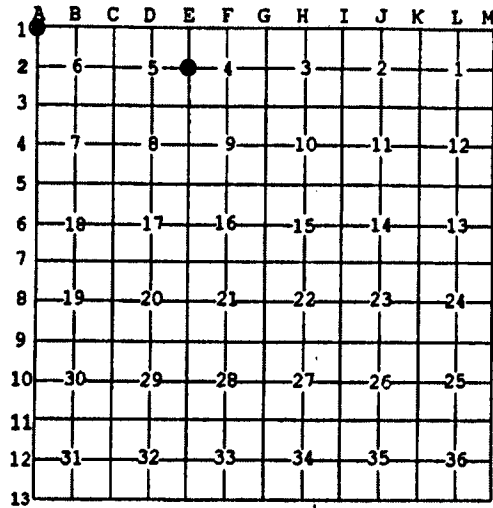

Signed by Stephan J. Szyszkoski
 Surveyor's Michigan License No. 33986

Date 11/22/05