

**LAND CORNER RECORDATION CERTIFICATE**  
**Filing Requirement of Act 74, Mich. P.A. 1970 as Amended**

For corners in

Baraga	Located In:	Corner Code #
(County)		
1. Public Land Survey	T 51N R 30W	C1
	T 51N R 30W	A3
	T _____ R _____	_____
	S _____ T _____ R _____	_____
2. Property Controlling in Section	S _____ T _____ R _____	_____
	S _____ T _____ R _____	_____
3. Miscellaneous Property in Sec.	S _____ T _____ R _____	_____
	S _____ T _____ R _____	_____

Register of Deeds Stamp & File Number

4. Lot No. \_\_\_\_\_, Recorded Plat \_\_\_\_\_

5. Private Claims

A3	Nov 22 2004
C1	Nov 23 2004

	A	B	C	D	E	F	G	H	I	J	K	L	M
1													
2	6		5		4		3		2		1		
3													
4	7		8		9		10		11		12		
5													
6	18		17		16		15		14		13		
7													
8	19		20		21		22		23		24		
9													
10	30		29		28		27		26		25		
11													
12	31		32		33		34		35		36		
13													

I, Stephan J. Szyszkoski, in a field survey on \_\_\_\_\_, 20\_\_\_\_ do hereby state that under requirements of P.A. 74, Michigan P.A. of 1970, the corner points mentioned in lines 1 and 2 above were in conformance with regulations and rules therefore as required in the current manual of survey instructions of the United States Department of the Interior, Bureau of Land Management or by a decree of a Court of Law and /or that the corner points mentioned in lines 3, 4 and 5 above were in conformance with the rules of the Michigan Board of Land Surveyors or by a Decree of a Court of Law; established, re-established, monumented, recovered, found as expressed below:

**NOTE: Not more than 2 corners, all in the same town and range, may be recorded on this certificate.**

**A. Description of original monument and accessories and/or subsequent restoration:**

(C1) Corner common to Sections 5-6 T51N-R30W and Sections 31-32 T52N-R30W. 1845 - Established by Wm. A. Burt. Cedar 30' Corner of Secs. 31 and 32. Hemlock 18 N70E 13. Undated notes by D.C.DeLaMater RLS - 1" pipe with 4" brass cap, 12" S.Maple N45E 34 links, 16" Hemlock S50W 20 links. 1965 - Recorded by Billy D. Buckler, RLS: This corner was re-witnessed as set by D. DeLaMater 6/18/53. Found NBT - 16" Hemlock S50W 20 links to be dead. 12" Soft Maple N45E, 34 links still in excellent condition. Corner monument 1" pipe with 4" brass cap. 1965 NBT: 8" Soft Maple N68W 09 links.

(A3) Corner common to Sections 6-7 T51N-R30W and Sections 1-12 T51N-R31W. 1953 - Remonumented by D.C.DeLaMater RLS: One orig. cedar BT still in place, excellent condition. Set 1" pipe with 4" brass cap 6/18/1953. NBTs: 16" Hemlock N33E 30 links, 8" Hemlock S70W 35 links (recorded Liber 2 Page 201 LCR, Baraga County Records).


**B. Description of corner evidence found and/or method applied in restoring or reestablishing corner:**

(C1) Found the 1953 monument in good condition and at record bearing and distance from the rotting remains of the 1953 Hemlock SW and Maple NE NBTs. Fd. rotting cedar laying on ground with base at pipe. No marks found but could be the remains of the original corner tree. Left the monument in place and made new witnesses as described below.

(A3) Recovered the 1953 monument in good condition and at record bearing and distance from the Hemlock SW NBT. The Hemlock NE was not recovered. Also found remains of Cedar with visible scars near the corner - possibly the remains of the Cedar DBT recovered by DeLaMater in 1953. Left the monument in place and made new witnesses as described below.

**C. Description of monument for corner and accessories established to perpetuate locating the position of the corner:**

(C1) Found 1" pipe with 4" brass cap.	(A3) Found 1" ID I.pipe with 4" brass
Set measuring nails in:	State of Michigan cap. Set measuring
24" Hemlock N32E 53.5' wrkd "S32 NBT"	nails in:
5" Y.Birch S33E 34.5' "S5 NBT"	17" Hemlock S78W 23.5' *
20" Hemlock N88W 27.0' "S31 NBT"	17" Hemlock N42W 30.6'
24" W.Pine N25W 50.9' do	15" Hemlock N34E 36.8'
Sq'd cedar post adjacent. Bearings are magnetic. Distances are to nail with tag.	5" Maple S01W 7.4'
	Set sq'd cedar post adjacent. Bearings are magnetic. Distances are to nail with tag. * denotes 1953 NBT.

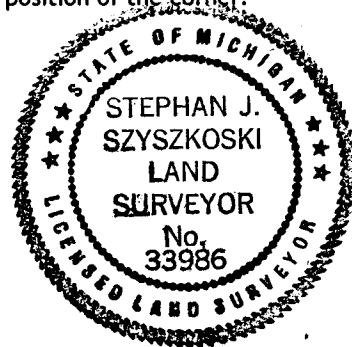

Signed by Stephan J. Szyszkoski  
 Surveyor's Michigan License No. 33986

Date 11/22/05