LAND CORNER RECORDATION CERTIFICATE
Filing Requirement of Act 74, Mich. P.A. 1970 as Amended

For corners in

Baraga
(County)

	Located In:	Corner Code #
1. Public Land Survey	T 51N R 30W	E1
	T 51N R 30W	F3
	T___ R___	
	S___ T___ R___	
2. Property Controlling	S___ T___ R___	
in Section	S___ T___ R___	
3. Miscellaneous	S___ T___ R___	
Property in Sec.	S___ T___ R___	

Register of Deeds Stamp & File Number

4. Lot No. _____ , Recorded Plat_____

5. Private Claims

F3 Jun 15 2005
E1 Jan 20 2005

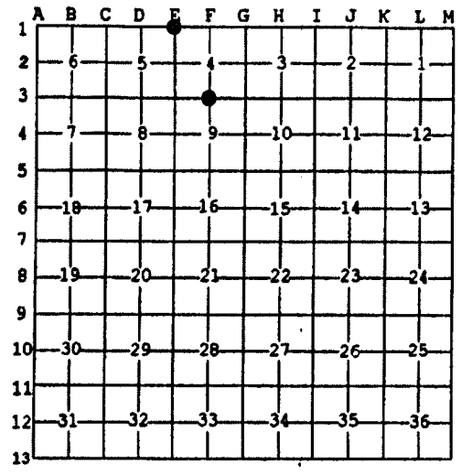

I, Stephan J. Szyszkoski, in a field survey on _____, 20 ____ do hereby state that under requirements of P.A. 74, Michigan P.A. of 1970, the corner points mentioned in lines 1 and 2 above were in conformance with regulations and rules therefore as required in the current manual of survey instructions of the United States Department of the Interior, Bureau of Land Management or by a decree of a Court of Law and /or that the corner points mentioned in lines 3, 4 and 5 above were in conformance with the rules of the Michigan Board of Land Surveyors or by a Decree of a Court of Law; established, re-established, monumented, recovered, found as expressed below:

NOTE: Not more than 2 corners, all in the same town and range, may be recorded on this certificate.

A. Description of original monument and accessories and/or subsequent restoration:

(E1) Corner common to Sections 4-5 T51N-R30W and Sections 32-33 T52N-R30W. 1965 - Remonumented by F.J.Bray, RLS: This corner was set from an original BT (12" Y.Birch N63W 33 links) which is down and has upper and lower faces. Down Cedar with axe marks (12" Cedar S08E 10 links) and badly rotted W.Pine stump (28" W.Pine S35W 23 links). Corner monument 1" iron pipe with 4" aluminum cap. Witnesses to corner: 14" Cedar S76E 62.5 links, 18" Cedar N60E 51 links.
(F3) Quarter corner common to Sections 4-9. 1846 - Established by Wm. Ives, Deputy Surveyor: West corrected between Sections 4 and 9 ...39.90 Set qr. Section post. Hemlock 6 S33E 29, Hemlock 20 N41W 30. ...79.80 Section corner.

B. Description of corner evidence found and/or method applied in restoring or reestablishing corner:

(E1) Recovered the 1965 monument in good condition and at record bearing and distance from the 1965 Cedar SE NBT, in good condition with scribing visible. Left the monument in place and made new witnesses as described below.
(F3) The original post and accessories were not recovered. Reestablished the corner midway and on the section line between Section corners 2623.90' east and west.

C. Description of monument for corner and accessories established to perpetuate locating the position of the corner:

(E1) Found 1"ID I.pipe with 4" alum. State of Michigan cap. Set measuring nails in:
14" Cedar S72E 41.9' scribing visible *
12" Cedar N89W 54.2' mrkd "S32 NBT"
7" B.Ash N35W 16.0' do
6" B.Ash N60E 5.1' "S33 NBT"
Set sq'd cedar post adjacent. Bearings are magnetic. Distances are to nail with tag. * denotes 1965 NBT.

(F3) Set 1"IDx32" I.pipe with 4" alum. MDNR cap. Set measuring nails in:
9" Sugar N32E 21.6' mrkd "1/4S NBT"
13" Sugar S80E 18.5' do
5" Y.Birch S35W 19.9' do
10" Hemlock N45W 33.0' do
Set sq'd Y.Birch post adjacent.
Bearings are magnetic. Distances are to nail with tag.

STATE OF MICHIGAN
STEPHAN J. SZYSZKOSKI
LAND SURVEYOR
No. 33986
LICENSED LAND SURVEYOR

Signed by Stephan J. Szyszkoski Date 11/22/05

Surveyor's Michigan License No. 33986

For the Michigan Department of Natural Resources, Office of Land and Facilities

FORM APPROVED BY MICHIGAN STATE BOARD OF PROFESSIONAL SURVEYORS, JAN. 28, 197
Revised May 14, 197
Revised Jan., 198
Rervised Oct., 199