LAND CORNER RECORDATION CERTIFICATE
Filing Requirement of Act 74, Mich. P.A. 1970 as Amended

For corners in

Baraga
(County)

		Located In:		Corner Code #
1. Public Land Survey		T 51N	R 30W	G2
		T____	R____	
		T____	R____	
	S____	T____	R____	
2. Property Controlling	S 4	T 51N	R 30W	1
in Section	S____	T____	R____	
3. Miscellaneous	S____	T____	R____	
Property in Sec.	S____	T____	R____	

Register of Deeds Stamp & File Number

4. Lot No. _____ , Recorded Plat_____

5. Private Claims

1 Jan 20 2005
G2 Jan 19 2005

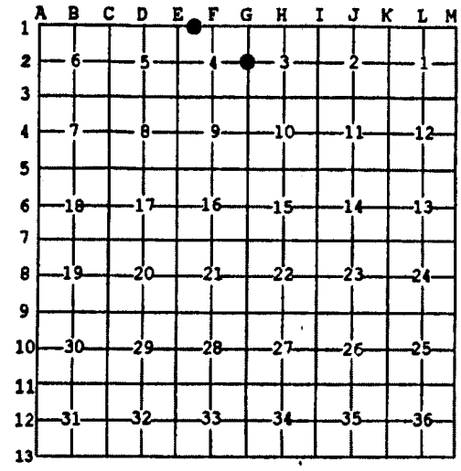

I, Stephan J. Szyszkoski, in a field survey on _____, 20____ do hereby state that under requirements of P.A. 74, Michigan P.A. of 1970, the corner points mentioned in lines 1 and 2 above were in conformance with regulations and rules therefore as required in the current manual of survey instructions of the United States Department of the Interior, Bureau of Land Management or by a decree of a Court of Law and /or that the corner points mentioned in lines 3, 4 and 5 above were in conformance with the rules of the Michigan Board of Land Surveyors or by a Decree of a Court of Law; established, re-established, monumented, recovered, found as expressed below:

NOTE: Not more than 2 corners, all in the same town and range, may be recorded on this certificate.

A. Description of original monument and accessories and/or subsequent restoration:

(G2) Quarter corner common to Sections 3 and 4. 1846 - Established by Wm. Ives, Deputy Surveyor: South corrected between 3 & 4 ...38.95 Set qr. Section post. Fir 8 S77W 14, Fir 8 N36E 16. ...78.95 Section corner.
(1-Sec. 4) West 1/16 corner between Section 4 T51N-R30W and Section 33 T52N-R30W. Not established in the original survey.

B. Description of corner evidence found and/or method applied in restoring or reestablishing corner:

(G2) The original post and accessories were not recovered. Reestablished the corner proportionate to the original record, on line between Section corners 2639.38' south and 2570.09' north.
(1-Sec. 4) Established the corner midway and on the township line between Section and Quarter corners 1312.55' West and East.

C. Description of monument for corner and accessories established to perpetuate locating the position of the corner:

(G2) Set 1"IDx32" I.pipe with 4" alum. MDNR cap. Set measuring nails in:
13" Hemlock N47E 14.7' mrkd "1/4S NBT"
12" Hemlock S35E 8.7' do
7" Spruce S86W 18.4' do
12" Y.Birch N19W 22.2' do
Set sq'd cedar post adjacent. Bearings are magnetic. Distances are to nail with tag.

(1) Set 1"IDx32" I.pipe with 4" alum. MDNR cap. Set measuring nails in:
14" Hemlock N45E 10.4' mrkd "1/16S BT"
15" Cedar S60E 24.7' do
14" Cedar S49W 26.4' do
13" Spruce N87W 27.0' do
Set sq'd cedar post adjacent. Bearings are magnetic. Distances are to nail with tag.

STATE OF MICHIGAN
STEPHAN J. SZYSZKOSKI
LAND SURVEYOR
No. 33986
LICENSED LAND SURVEYOR

Signed by Stephan J. Szyszkoski Date 11/22/05

Surveyor's Michigan License No. 33986

For the Michigan Department of Natural Resources, Office of Land and Facilities

FORM APPROVED BY MICHIGAN STATE BOARD OF PROFESSIONAL SURVEYORS, JAN. 28, 197
Revised May 14, 197
Revised Jan., 198
Rervised Oct., 199