LAND CORNER RECORDATION CERTIFICATE
Filing Requirement of Act 74, Mich. P.A. 1970 as Amended

For corners in

Baraga
(County)

	Located In:	Corner Code #
1. Public Land Survey	T 51N R 30W	G3
	T 51N R 30W	E3
	T___ R___	
	S___ T___ R___	
2. Property Controlling	S___ T___ R___	
in Section	S___ T___ R___	
3. Miscellaneous	S___ T___ R___	
Property in Sec.	S___ T___ R___	

Register of Deeds Stamp & File Number

4. Lot No. _____ , Recorded Plat_____
5. Private Claims

E3 Jun 16 2005
G3 Jun 23 2005

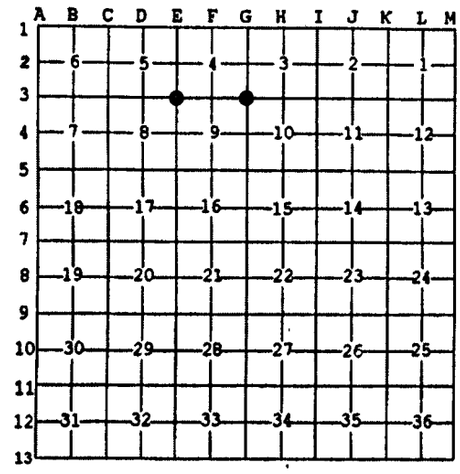

I, Stephan J. Szyszkoski, in a field survey on _____, 20____ do hereby state that under requirements of P.A. 74, Michigan P.A. of 1970, the corner points mentioned in lines 1 and 2 above were in conformance with regulations and rules therefore as required in the current manual of survey instructions of the United States Department of the Interior, Bureau of Land Management or by a decree of a Court of Law and /or that the corner points mentioned in lines 3, 4 and 5 above were in conformance with the rules of the Michigan Board of Land Surveyors or by a Decree of a Court of Law; established, re-established, monumented, recovered, found as expressed below:

NOTE: Not more than 2 corners, all in the same town and range, may be recorded on this certificate.

A. Description of original monument and accessories and/or subsequent restoration:

(G3) Corner common to Sections 3-4-9-10. 1846 - Established by Wm.Ives, Deputy Surveyor: North between Sections 9&10 ... 80.00 Set post corner of Secs. 3-4-9-10. Sugar 14 S22E 17 links, Sugar 12 N62W 32 links. Notes of N.T.Thompson, RLS, ca. 1942 state: "West corr. bet Sec. 4 & 9, this post was set in '38 by D.M.O. Y.A.T. N.T.T."
(E3) Corner common to Sections 4-5-8-9. 1965 - Corner position remonumented by F.J.Bray from 2 original bearing trees "Hemlocks, down, rotted by [sic] faces and portions of scribe marks visible. 3/4" iron pipe at corner". Set 1" iron pipe with 4" aluminum cap. Witnesses to corner: 8" Aspen S45W 26.5 links, 7" Aspen S72E 31 links, 6" Aspen N44E 22.5 links.

B. Description of corner evidence found and/or method applied in restoring or reestablishing corner:

(G3) The original post and accessories were not recovered. Found a 3/4" ID iron pipe at the intersection of blue paint lines south and west. Measured distance north to G1 of record 5209.47' (5210.7 GLO) and west to E3 of record 5247.81 (5266.8 GLO). Accepted the pipe as the best available evidence of the position of the original corner and replaced it with a new monument as described below.
(E3) Found the 1965 monument in good condition but with disc of aluminum cap broken off. Stem of cap is still riveted in pipe. The 3/4" pipe noted in the 1965 record was found adjacent. Found no evidence of the 1965 NBTs. The position of the monument checks well with corners E1 and E2, north, and I conclude that it is in the 1965 position. Accepted the monumented position as a careful and faithful perpetuation of the position of the original corner.

C. Description of monument for corner and accessories established to perpetuate locating the position of the corner:

(G3) Fd. 3/4" ID iron pipe and replaced it with a 1"IDx32" I.pipe with 4" alum MDNR cap. Set measuring nails in:
4" Sugar N30E 22.4' mrkd "S3 NBT"
8" Hemlock N66E 25.3' "S3 NBT"
8" Sugar S21E 24.4' "S10 NBT"
10" Maple N88W 10.8' "S4 NBT"
Bearings are magnetic. Distances are to nail with tag.

(E3) Found 1"ID I.pipe with stem of aluminum cap affixed. Set measuring nails in:
4" Sugar N32E 25.1' mrkd "S4 NBT"
3" Sugar S74E 13.0' "S9 NBT"
5" Y.Birch S19W 12.1' "S8 NBT"
6" Sugar N54W 11.8' "S5 NBT"
Set sq'd cedar post adjacent. Bearings are magnetic. Distances are to nail with tag.

STATE OF MICHIGAN
STEPHAN J. SZYSZKOSKI
LAND SURVEYOR
No. 33986
LICENSED LAND SURVEYOR

Signed by Stephan J. Szyszkoski Date 11/22/05

Surveyor's Michigan License No. 33986

For the Michigan Department of Natural Resources, Office of Land and Facilities

FORM APPROVED BY MICHIGAN STATE BOARD OF PROFESSIONAL SURVEYORS, JAN. 28, 1
Revised May 14, 1
Revised Jan., 1
Rervised Oct., 1