


LAND CORNER RECORDATION CERTIFICATE
Filing Requirement of Act 74, Mich. P.A. 1970 as Amended

For corners in

<u>Baraga</u> (County)	Located In:	Corner Code #
1. Public Land Survey	T _____ R _____	_____
	T _____ R _____	_____
	T _____ R _____	_____
2. Property Controlling in Section	S <u>18</u> T <u>51N</u> R <u>31W</u>	SMC N. of #8
	S <u>18</u> T <u>51N</u> R <u>31W</u>	PCC S. of C5
	S _____ T _____ R _____	_____
3. Miscellaneous Property in Sec.	S _____ T _____ R _____	_____
	S _____ T _____ R _____	_____
4. Lot No. _____, Recorded Plat _____		
5. Private Claims _____		

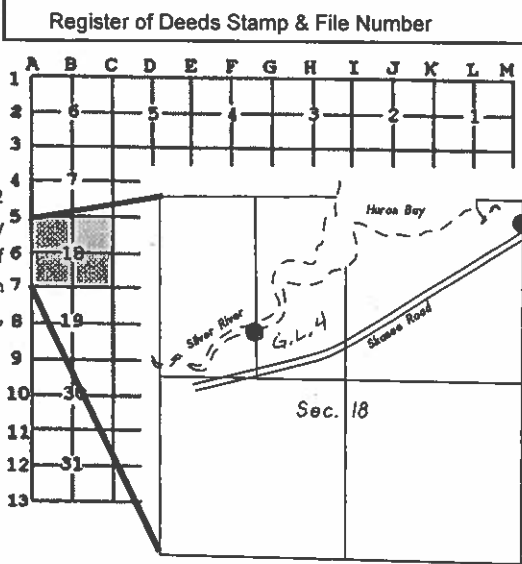

I, Stephan J. Szyszkoski, in a field survey on 01/09/2012 do hereby state that under requirements of P.A. 74, Michigan P.A. of 1970, the corner points mentioned in lines 1 and 2 above were in conformance with regulations and rules therefore as required in the current manual of survey instructions of the United States Department of the Interior, Bureau of Land Management or by a decree of a Court of Law and /or that the corner points mentioned in lines 3, 4 and 5 above were in conformance with the rules of the Michigan Board of Land Surveyors or by a Decree of a Court of Law; established, re-established, monumented, recovered, found as expressed below:

NOTE: Not more than 2 corners, all in the same town and range, may be recorded on this certificate.

A. Description of original monument and accessories and/or subsequent restoration:

(SMC N. of #8) Special Meander Corner on the West 1/16 line of Section 18, being the line between Government Lots 4 & 5, on the south shore of the Silver River. Not previously monumented.

(PCC S. of C5) A property controlling corner on the Section line between Sections 17 and 18, between Skaneec Road and Section corner C5. Not previously monumented.

B. Description of corner evidence found and/or method applied in restoring or reestablishing corner:

(SMC) Established the corner on a straight line between 1/16 corners #1 and #8, both of record, 676.92' north of 1/16 corner #8 and 1988.58' south of 1/16 corner #1. The monumented position falls 25' south of the water's edge of the Silver River.

(PCC S. of C5) Established the corner on the Section line between Section corner C5 447.49' north and Quarter corner C6 2232.75' south. The position monumented lies approx. 66' north of the constructed centerline of the Skaneec Road. This position does NOT fall on the northerly Right-of-Way line of Skaneec Road. No attempt was made to reestablish the location of the Right-of-Way of Skaneec Road (abandoned State Hwy. M-35).

C. Description of monument for corner and accessories established to perpetuate locating the position of the corner:

(SMC) Set 1"IDx32" I.pipe with 4" alum. MDNR cap. Set measuring nail with MDNR tag in the side of:
 8" Cedar N56E 18.3' mrkd "SMC BT"
 14" Cedar S50E 14.9' do
 3" Balsam S88W 8.35' do
 10" Cedar N15W 4.7' do
 Set sq'd cedar post adjacent.
 Bearings are magnetic.

(PCC) Set 1"IDx32" I.pipe with 4" alum. MDNR cap. Set measuring nail with MDNR tag in the side of:
 4" B.Ash N64E 16.2' mrkd "POL BT"
 9" Cedar S18W 12.8' do
 9" Cedar N67W 7.7' do
 10" Cedar N23W 13.2' do
 Set sq'd cedar post adjacent.
 Bearings are magnetic.

Signed by Stephan J. Szyszkoski
 Surveyor's Michigan License No. 33986

Date 01/24/2012

For the Michigan Department of Natural Resources, Forest Management Division

