

**SURVEY &
REMONUMENTATION**

APR 26 1995

COMMISSION

**LAND CORNER RECORDATION CERTIFICATE
Filing Requirement of Act 74, Mich. P.A. 1970**

For corners in

<u>Baraga</u> (County)	Located In:	Corner Code #
	51N 31W	B-13
1. Public Land Survey	T _____ R _____	_____
	T _____ R _____	_____
	T _____ R _____	_____
	T _____ R _____	_____
2. Property Controlling in Section	S _____ T _____ R _____	_____
	S _____ T _____ R _____	_____
3. Miscellaneous Property in Sec.	S _____ T _____ R _____	_____
	S _____ T _____ R _____	_____
4. Lot No. _____, Recorded Plat _____		
5. Private Claims _____		

RECEIVED FOR RECORD THIS 19TH DAY OF DECEMBER, A.D. 1994 AT 9:00 A.M. AND RECORDED IN LIBER 4 OF LAND CORNER RECORDATION ON PAGES 527-528.

Theda J. Robillard

BARAGA COUNTY REGISTER OF DEEDS

Register of Deeds Stamp & File Number

I, Michael Mileski, in a field survey on December 94, 19

do hereby certify that under requirements of P.A. 74, Michigan P.A. of 1970, the corner points mentioned in lines 1 and 2 above were in conformance with regulations and rules therefore as required in the current manual of survey instructions of the United States Department of the Interior, Bureau of Land Management or by a decree of a Court of Law and/or that the corner points mentioned in lines 3, 4 and 5 above were in conformance with the rules of the Michigan Board of Land Surveyors or by a Decree of a Court of Law; established, re-established, monumented, re-monumented, recovered, found as expressed below:

NOTE: Not more than 4 corners, all in the same town and range, may be recorded on this certificate.

A	B	C	D	E	F	G	H	I	J	K	L	M
2	6	5	4	3	2	1						
3												
4	7	8	9	10	11	12						
5												
6	18	17	16	15	14	13						
7												
8	19	20	21	22	23	24						
9												
10	30	29	28	27	26	25						
11												
12	31	32	33	34	35	36						
13												


A. Description of original monument and accessories and/or subsequent restoration:

B-13; South One-quarter Corner Section 31, T51N, R31W, on 5th Correction Line.

See back of form.

APPROVED LAND CORNER
P.A. 345 OF 1990
Baraga County

[Signature]
12-9-94

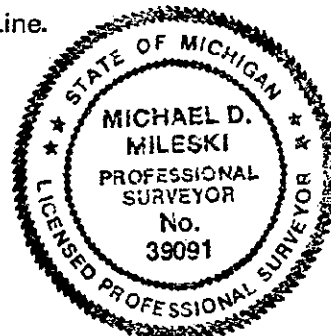

B. Description of corner evidence found and/or method applied in restoring or reestablishing corner:

B-13; South One-quarter Corner Section 31, T51N, R31W, on 5th Correction Line.

Found Mr. Schmeling's 1" x 48" galvanized iron pipe with stamped 4" brass cap projecting 18" above the ground to be in agreement with both his witnesses of record and with the remains of both U.S. bearing trees the condition of each as described in Part A. I did not remonument the corner.

C. Description of monument for corner and accessories established to perpetuate locating the position of the corner:

B-13; South One-quarter Corner Section 31, T51N, R31W, on 5th Correction Line.

Found 1" x 48" galvanized iron pipe with 4" brass cap appropriately stamped as to location.

Set 60d Spike	SE/side	11" Red Oak	N53°E	26.62'
Set 60d Spike	W/side	10" Hemlock	S36°E	12.41'
Set 60d Spike	SE/side	14" Hemlock	S12°W	19.65'
Set 60d Spike	N/side	14" Hemlock	S83°W	25.98'

All of the above new bearing trees marked with upper and lower face blazes and scribed "NBT".

Signed by Michael Mileski Date 19 December 1994

Surveyor's Michigan License No. 39091

LIBER 4 PAGE 527

A. Description of original monument and accessories and/or subsequent restoration:

B-13; South One-quarter Corner Section 31, T51N, R31W, on 5th Correction Line.

Originally established during U.S. Survey conducted by Austin Burt, D.S., in 1845 and monumented with a wood post witnessed by a

Hemlock 10 N57°E 46 lks.

(Recovered as a severely decayed stump 14" ± in dia. having no identifiable marks.)

and a

Birch 6 N52°W 43 lks.

(Recovered as a moderately decayed stump 16" ± in dia. having no identifiable marks.)

The late Norman Thompson, RLS #4348, states in his field notes dated November 1941 (copies of which were obtained from Northern Hardwoods' office in L'Anse) that he found both U.S. bearing trees to be "ok". Mr. Thompson does not indicate what he used to remonument the corner. Mr. Thompson noted the following new bearing trees:

Yellow Birch 8 N15°E 31'6"

(Recovered as a solid stump 18" in dia. having no identifiable marks.)

and a

Yellow Birch 7 N70°W 18'5"

(Presently alive and 16" in dia. having healed upper and lower face blazes.
Set 60d spike N/side N70°W 18.40')

According to a Land Corner Recordation Certificated filed by Robert Schmeling, P.S. #8317, and recorded Liber 1 page 307 during the course of a field survey conducted 26 April 1978, Mr. Schmeling recovered a wood post rotted off at ground level in agreement with Mr. Thompson's new bearing trees. Mr. Schmeling noted the following new bearing trees:

Red Maple 6.6" N40°E 25.7' to CL

(Presently alive 10" in dia. having healed lower face blaze.
Set 60d spike SE/side N38°E 25.7')

and a

Red Maple 8.2" N44°W 16.7' to CL

(Presently alive 13" in dia. having healed lower blaze.
Set 60d spike SW/side N45°W 16.70')