

SURVEY & REMONUMENTATION

FEB 23 1998

LAND CORNER RECORDATION CERTIFICATE
Filing Requirement of Act 74, Mich. P.A. 1970

For corners in

SECTION

Baraga

(County)

Located in:

Corner Code #

- | | | |
|------------------------------------|---------------------------|-------------|
| 1. Public Land Survey | T <u>51N</u> R <u>32W</u> | <u>B-13</u> |
| | T _____ R _____ | _____ |
| | T _____ R _____ | _____ |
| | T _____ R _____ | _____ |
| 2. Property Controlling in Section | S _____ T _____ R _____ | _____ |
| | S _____ T _____ R _____ | _____ |
| 3. Miscellaneous Property in Sec. | S _____ T _____ R _____ | _____ |
| | S _____ T _____ R _____ | _____ |

RECEIVED FOR RECORD THIS 31ST DAY OF DECEMBER A.D. 1997 AT 10:30 A.M. AND RECORDED IN LIBER 4 OF LAND CORNER RECORDATION RECORDS ON PAGE 806.

Relda Bishop

BARAGA COUNTY REGISTER OF DEEDS

Register of Deeds Stamp & File Number

4. Lot No. _____, Recorded Plat _____
 5. Private Claims _____

I, Michael Mileski, in a field survey on 21 November, 19 97 do hereby state that under requirements of P.A. 74, Michigan P.A. of 1970, the corner points mentioned in lines 1 and 2 above were in conformance with regulations and rules therefore as required in the current manual of survey instructions of the United States Department of the Interior, Bureau of Land Management or by a decree of a Court of Law and /or that the corner points mentioned in lines 3, 4 and 5 above were in conformance with the rules of the Michigan Board of Land Surveyors or by a Decree of a Court of Law; established, re-established, monumented, recovered, found as expressed below:

NOTE: Not more than 2 corners, all in the same town and range, may be recorded on this certificate.

A. Description of original monument and accessories and/or subsequent restoration:

B-13; South One-quarter Corner Section 31, T51N, R32W, on 5th Correction Line;

Originally established during U.S. Survey conducted by Austin Burt, D.S. in 1845 and monumented with a wood post witnessed by a Hemlock 7 N54°E 31 lks. and a Birch 11 N54°W 15 lks.

This corner was considered lost during the course of a survey conducted by Stephen Douglas of the Bureau of Land Management from 13 May 1987 to 4 November 1987 and approved on 24 March 1989. Mr. Douglas did not remonument the corner.

APPROVED LAND CORNER
 P.A. 345 OF 1990
 Baraga County

B. Description of corner evidence found and/or method applied in restoring or reestablishing corner:

B-13; South One-quarter Corner Section 31, T51N, R32W, on 5th Correction Line;

This corner was considered lost and reestablished on line at the proportionate distance between the SW corner of section 31 and the SE corner of section 31.

C. Description of monument for corner and accessories established to perpetuate locating the position of the corner:


B-13; South One-quarter Corner Section 31, T51N, R32W, on 5th Correction Line;

Set a 1" (I.D.) x 36" galvanized iron pipe with cap stamped as to location projecting 6" above ground.

- | | | | | |
|--------------|---------|------------------------------------|-------|--------|
| Set 7" spike | S/side | 14" Aspen | N81°E | 25.35' |
| Set 7" spike | SW/side | 6" Red Maple | S62°E | 74.26' |
| Set 7" spike | E/side | 6" Red Maple | S05°W | 4.96' |
| Set 7" spike | NE/side | 8" Red Maple | N68°W | 25.73' |
| Set 7" spike | E/side | 10" White Spruce | N07°W | 9.81' |
| | | 6" Steel fence post w/ yellow sign | North | 1.5' |

All of the above new bearing trees are marked with upper and lower blazes. The lower blaze is scribed "NBT". Both blazes and a band around the tree at the upper blaze were painted red.

LIBER 4 PAGE 806

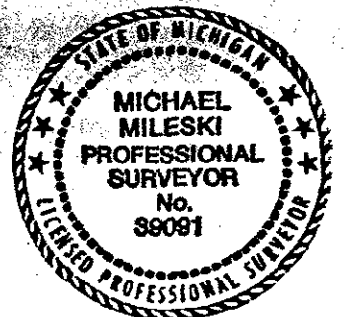

Signed by *Michael Mileski*
 Surveyor's Michigan License No. 39091

Date 23 Dec 1997