

**SURVEY &
REMONUMENTATION**

APR 26 1995

COMMISSION

LAND CORNER RECORDATION CERTIFICATE

Filing Requirement of Act 74, Mich. P.A. 1970

For corners in

Baraga

(County)

Located In:

Corner Code #

- | | | | | | |
|------------------------------------|---|-----|---|-----|------|
| 1. Public Land Survey | T | 51N | R | 32W | D-13 |
| | T | | R | | |
| | T | | R | | |
| | T | | R | | |
| 2. Property Controlling in Section | S | | T | R | |
| | S | | T | R | |
| 3. Miscellaneous Property in Sec. | S | | T | R | |
| | S | | T | R | |

RECEIVED FOR RECORD THIS 19TH DAY OF DECEMBER, A.D. 1994 AT 9:00 A.M. AND RECORDED IN LIBER 4 OF LAND CORNER RECORDATION ON PAGES 539-540.

BARAGA COUNTY REGISTER OF DEEDS

Register of Deeds Stamp & File Number

4. Lot No. _____, Recorded Plat _____
5. Private Claims _____

A	B	C	D	E	F	G	H	I	J	K	L	M
2	6	5	4	3	2	1						
3												
4	7	8	9	10	11	12						
5												
6	18	17	16	15	14	13						
7												
8	19	20	21	22	23	24						
9												
10	30	29	28	27	26	25						
11												
12	31	32	33	34	35	36						
13												

I, Michael Mileski, in a field survey on April, 1994, do hereby certify that under requirements of P.A. 74, Michigan P.A. of 1970, the corner points mentioned in lines 1 and 2 above were in conformance with regulations and rules therefore as required in the current manual of survey instructions of the United States Department of the Interior, Bureau of Land Management or by a decree of a Court of Law and/or that the corner points mentioned in lines 3, 4 and 5 above were in conformance with the rules of the Michigan Board of Land Surveyors or by a Decree of a Court of Law; established, re-established, monumented, re-monumented, recovered, found as expressed below:

NOTE: Not more than 4 corners, all in the same town and range, may be recorded on this certificate.


A. Description of original monument and accessories and/or subsequent restoration:

D-13; South One-quarter Corner Section 32, T51N, R32W, on 5th Correction Line.

See back of form.

APPROVED LAND CORNER
P.A. 345 OF 1990
Baraga County

Mileski
12-9-94

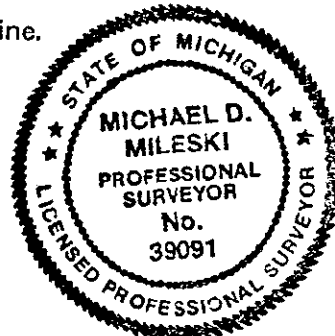

3. Description of corner evidence found and/or method applied in restoring or reestablishing corner:

D-13; South One-quarter Corner Section 32, T51N, R32W, on 5th Correction Line.

Set 1/2" x 18" iron rod from the remains of both U.S. bearing trees the condition of which is described in Part A, this iron rod was subsequently replaced by Stephen Douglas of the BLM with a 2 1/2" x 30" aluminum pipe with 3" stamped cap. Accepted as a careful and faithful perpetuation of the position of the original corner.

2. Description of monument for corner and accessories established to perpetuate locating the position of the corner:

D-13; South One-quarter Corner Section 32, T51N, R32W, on 5th Correction Line.

Corner monumented with 2 1/2" x 30" aluminum pipe with a 3" cap appropriately stamped as to location.

Set 60d spike	SE/side	11" Jack Pine	N36°E	11.41'
Set 60d spike	NW/side	5" Red Pine	N55°E	37.43'
Set 60d spike	SW/side	14" Jack Pine	S33°E	19.60'
Set 60d spike	W/side	8" Jack Pine	N36°W	31.13'
		1 1/4" iron pipe	S19°W	25.38'

All of the above new bearing trees marked with upper and lower face blazes and scribed "NBT".

igned by Michael Mileski Date 19 December 1994

urveyor's Michigan License No. 39091

LIBER 4 PAGE 539

A. Description of original monument and accessories and/or subsequent restoration:

D-13; South One-quarter Corner Section 32, T51N, R32W, on 5th Correction Line.

Originally established during U.S. Survey conducted by Austin Burt, D.S. in 1845 and monumented with a wood post witnessed by a

Yellow Pine 10 N23°E 26 lks.

(Recovered as a 40" tall burned stump with the lower half of the lower face blaze still evident. Partial chaining notch at the base of the lower face blaze also evident.)

and a

White Pine 10 N53°W 42 lks.

(Recovered as a severely decayed 16" ± dia. stump 18" tall having no identifiable marks.)

During the course of a survey conducted by Stephen Douglas of the Bureau of Land Management from 27 May 1985 to 30 September 1986 and approved 17 February 1989, this corner was considered lost and monumented at the single-proportioned position. Mr. Douglas later informed me that he had replaced my temporary ½" x 18" iron rod with a 2½" x 30" aluminum pipe with 3" cap appropriately stamped as to location.

Keith Sackett, P.S., Baraga County Representative, and I examined the physical evidence described above on 12 May 1994.