

AUG 05 1994

COMMISSION

LAND CORNER RECORDATION CERTIFICATE
Filing Requirement of Act 74, Mich. P.A. 1970

For corners in
Baraga
(County)

Located In:

Corner Code #

- | | | |
|------------------------------------|---------------------------|-------------|
| 1. Public Land Survey | T <u>51N</u> R <u>33W</u> | <u>B-13</u> |
| | T _____ R _____ | _____ |
| | T _____ R _____ | _____ |
| | T _____ R _____ | _____ |
| 2. Property Controlling in Section | S _____ T _____ R _____ | _____ |
| | S _____ T _____ R _____ | _____ |
| 3. Miscellaneous Property in Sec. | S _____ T _____ R _____ | _____ |

RECEIVED FOR RECORD THIS 2ND DAY OF AUGUST, A.D. 1994 AT 9:00 A.M. AI RECORDED IN LIBER 4 OF LAND CORNER RECORDATION ON PAGE 489.

Dennis J. Robillard
 BARAGA COUNTY REGISTER OF DEEDS

Register of Deeds Stamp & File Number

4. Lot No. _____, Recorded Plat _____
 5. Private Claims _____

I, Dennis R. Destrampe, in a field survey on December 17, 1993, do hereby certify that under requirements of P.A. 74, Michigan P.A. of 1970, the corner points mentioned in lines 1 and 2 above were in conformance with regulations and rules therefore as required in the current manual of survey instructions of the United States Department of the Interior, Bureau of Land Management or by a decree of a Court of Law and/or that the corner points mentioned in lines 3, 4 and 5 above were in conformance with the rules of the Michigan Board of Land Surveyors or by a Decree of a Court of Law; established, re-established, monumented, re-monumented, recovered, found as expressed below:

NOTE: Not more than 4 corners, all in the same town and range, may be recorded on this certificate.


A	B	C	D	E	F	G	H	I	J	K	L	M
2	6	5	4	3	2	1						
3												
4	7	8	9	10	11	12						
5												
6	18	17	16	15	14	13						
7												
8	19	20	21	22	23	24						
9												
10	30	29	28	27	26	25						
11												
12	31	32	33	34	35	36						
13												

A. Description of original monument and accessories and/or subsequent restoration:

Wood Post	Original corner not found. No record of subsequent restoration.
Birch 10 N40E 12	
Birch 8 N62W 33	

B. Description of corner evidence found and/or method applied in restoring or reestablishing corner:

No evidence found of original corner or subsequent restoration. Traverse was run from the SW corner of Section 31 to the SE corner of Section 31. The corner was set by single proportionate method.

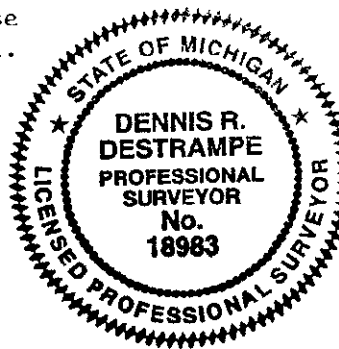

APPROVED LAND CORNER
 P.A. 345 OF 1990
 Baraga County

HD
12-1-93

C. Description of monument for corner and accessories established to perpetuate locating the position of the corner:

Set 1"X36" pipe with 2½" brass cap 6" above ground. Baraga Cty. Remonumentation brass cap stamped:

Witnesses:

- | | |
|------------------------|---|
| W face 10" Sugar Maple | N01E 23.51' (Nail & tag "UPEA 18983" set) |
| N face 6" Cedar | N70E 30.01' (Nail & tag "UPEA 18983" set) |
| N face 6" Red Maple | N70W 11.83' (Nail & tag "UPEA 18983" set) |
| SW face 7" Hemlock | N17W 17.14' (Nail & tag "UPEA 18983" set) |

SC
 T51N R33W
 1/4 S31
 1994

All of the above new bearing trees are scribed "NBT".

Signed by Dennis R. Destrampe Date June 22, 1994
 Surveyor's Michigan License No. 18983