

**SURVEY & REMONUMENTATION**

AUG 05 1994

**COMMISSION**

**LAND CORNER RECORDATION CERTIFICATE**  
**Filing Requirement of Act 74, Mich. P.A. 1970**

For corners in

<u>Baraga</u> (County)	Located In:	Corner Code #
1. Public Land Survey	T <u>51N</u> R <u>33W</u>	<u>C-13</u>
	T _____ R _____	_____
	T _____ R _____	_____
	T _____ R _____	_____
2. Property Controlling in Section	S _____ T _____ R _____	_____
	S _____ T _____ R _____	_____
3. Miscellaneous Property in Sec.	S _____ T _____ R _____	_____
	S _____ T _____ R _____	_____

RECEIVED FOR RECORD THIS 2ND DAY OF AUGUST, A.D. 1994 AT 9:00 A.M. / RECORDED IN LIBER 4 OF LAND CORNER RECORDATION ON PAGE 488.

*Della J. Robillard*  
 BARAGA COUNTY REGISTER OF DEEDS

Register of Deeds Stamp & File Number

4. Lot No. \_\_\_\_\_, Recorded Plat \_\_\_\_\_  
 5. Private Claims \_\_\_\_\_

I, Dennis R. Destrampe, in a field survey on December 17, 1993, do hereby certify that under requirements of P.A. 74, Michigan P.A. of 1970, the corner points mentioned in lines 1 and 2 above were in conformance with regulations and rules therefore as required in the current manual of survey instructions of the United States Department of the Interior, Bureau of Land Management or by a decree of a Court of Law and/or that the corner points mentioned in lines 3, 4 and 5 above were in conformance with the rules of the Michigan Board of Land Surveyors or by a Decree of a Court of Law; established, re-established, monumented, re-monumented, recovered, found as expressed below:

A	B	C	D	E	F	G	H	I	J	K	L	A
2	6	5	4	3	2	1						
3												
4	7	8	9	10	11	12						
5												
6	18	17	16	15	14	13						
7												
8	19	20	21	22	23	24						
9												
10	30	29	28	27	26	25						
11												
12	31	32	33	34	35	36						
13												

**NOTE: Not more than 4 corners, all in the same town and range, may be recorded on this certificate.**

**A. Description of original monument and accessories and/or subsequent restoration:**

Wood Post  
 Hemlock 18 N81E 18  
 Sugar 7 N50W 42

Original corner not found. Re-established 5/7/76, recorded Liber 1, Page 268, Land Corner Recordation.


**B. Description of corner evidence found and/or method applied in restoring or reestablishing corner:**

Found 1" iron pipe with 3 3/4" aluminum cap stamped T51N, R33W, 31|32, A.O. Enger, RLS 13581, 5/7/76; as described in Liber 1, Page 268, Land Corner Recordation.

Witnesses found:

- 8" Red Maple N45E 4.0' FHB top, NBT bottom
- 6" Sugar Maple S30E 4.1' S2 top, NBT bottom
- 4" Red Maple N50W 11.5' FHB top, and bottom

APPROVED LAND CORNER  
 P.A. 345 OF 1990  
 Baraga County

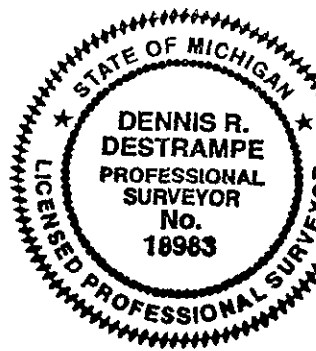

**C. Description of monument for corner and accessories established to perpetuate locating the position of the corner:**

Corner accepted as found.

Witnesses:

- NW face 8" Red Maple N45E 4.24' (Nail & tag "UPEA 18983" set)
- W face 6" Sugar Maple S30E 4.32' (Nail & tag "UPEA 18983" set)
- N face 4" Red Maple N50W 11.64' (Nail & tag "UPEA 18983" set)
- S face 8" Sugar Maple S80W 28.54' (Nail & tag "UPEA 18983" set, scribed "NBT")

Signed by *Dennis R. Destrampe*  
 Surveyor's Michigan License No. 18983

Date June 21, 1994