

**SURVEY &  
REMONUMENTATION**

MAY 05 1997

**LAND CORNER RECORDATION CERTIFICATE  
Filing Requirement of Act 74, Mich. P.A. 1970**

For corners in

**COMMISSION**

<u>Baraga</u> <small>(County)</small>	Located In:	Corner Code #	
1. Public Land Survey	T <u>51N</u> R <u>33W</u>	E-5	
	T _____ R _____		
	T _____ R _____		
	T _____ R _____		
2. Property Controlling in Section	S _____ T _____ R _____		
	S _____ T _____ R _____		
3. Miscellaneous Property in Sec.	S _____ T _____ R _____		
	S _____ T _____ R _____		

RECEIVED FOR RECORD THIS 20TH DAY OF DECEMBER, 1996 AT 10:30 A.M. AND RECORDED IN LIBER 4 OF LAND CORNER RECORDATION RECORDS ON PAGES 722-723.

*Relda McAntyre*  
BARAGA COUNTY REGISTER OF DEEDS

Register of Deeds Stamp & File Number

4. Lot No. \_\_\_\_\_, Recorded Plat \_\_\_\_\_  
5. Private Claims \_\_\_\_\_

I, Michael Mileski, in a field survey on November, 19 96 do hereby state that under requirements of P.A. 74, Michigan P.A. of 1970, the corner points mentioned in lines 1 and 2 above were in conformance with regulations and rules therefore as required in the current manual of survey instructions of the United States Department of the Interior, Bureau of Land Management or by a decree of a Court of Law and /or that the corner points mentioned in lines 3, 4 and 5 above were in conformance with the rules of the Michigan Board of Land Surveyors or by a Decree of a Court of Law; established, re-established, monumented, recovered, found as expressed below:

**NOTE:** Not more than 2 corners, all in the same town and range, may be recorded on this certificate.

A. Description of original monument and accessories and/or subsequent restoration:

E-5; Section Corner common to Sections 8, 9, 16, and 17, T51N, R33W;

See back of form.

B. Description of corner evidence found and/or method applied in restoring or reestablishing corner:

E-5; Section Corner common to Sections 8, 9, 16, and 17, T51N, R33W;

Found a 2½" diameter aluminum pipe with a 3" aluminum cap projecting 8 inches above the ground as set by the BLM in 1984. The position of this monument was verified by a traverse. I did not remonument the corner, but stamped "PA 345 1996" to the cap. Accepted as a careful and faithful reestablishment of the position of the original corner.

C. Description of monument for corner and accessories established to perpetuate locating the position of the corner:


E-5; Section Corner common to Sections 8, 9, 16, and 17, T51N, R33W;

Found a 2½" aluminum pipe with a 3" aluminum cap stamped as to location projecting 8 inches above the ground.

i)	Set 7" spike	W/side	20" Hemlock	N04°E	33.35'
ii)	Set 7" spike	S/side	8" Yellow Birch	S84°E	14.67'
iii)	Set 7" spike	SW/side	5" Yellow Birch	S30°E	44.55'
iv)	Set 7" spike	SE/side	17" Sugar Maple	S70°W	57.75'
v)	Set 7" spike	SW/side	20" Hemlock	N54°W	81.50'
vi)	Set 7" spike	E/side	6" Sugar Maple	N13°W	13.11'
			Location Post	North	1.0'

(i), (iii), and (iv), and (v) are BLM new bearing trees and are further described in Part A.

(ii) and (vi) are marked with upper and lower blazes. The lower blaze is scribed "NBT". Both blazes as well as a band around the tree at the upper blaze are painted red.

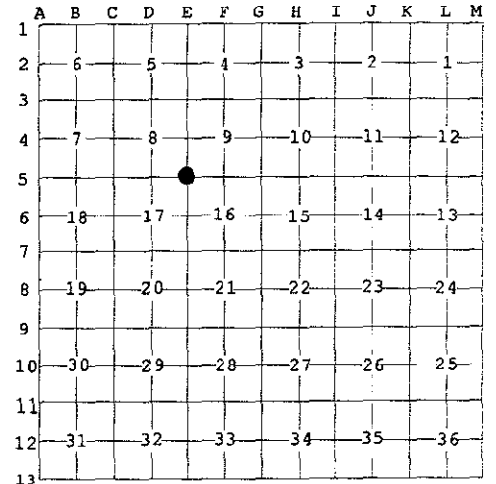

APPROVED LAND CORNER  
P.A. 345 OF 1990  
Baraga County

*ML*  
12-19-96



Signed by \_\_\_\_\_

Date 18 Dec 1996

Surveyor's Michigan License No. 39091

A. Description of original monument and accessories and/or subsequent restoration:

E-5; Section Corner common to Sections 8, 9, 16, and 17, T51N, R33W;

Originally established during U.S. Survey conducted by Harvey Mellen, D.S. in 1845 and monumented with a fir post witnessed by a

Cedar	20	S75°W	14 lks.
and a			
Fir	10	N04°E	21 lks.

During the course of a survey conducted by Stephen Douglas of the Bureau of Land Management from 10 May 1984 to 10 November 1984 and approved 23 September 1985, this corner was considered lost and reestablished by double proportionate measure. This position fits the U.S. stream calls well. The BLM monumented this corner with a 2½" x 30" aluminum pipe and cap witnessed by a

Hemlock	18	N08°E	25 lks. (16.50')
Presently alive and 20" in diameter having a partially healed lower blaze with scribing visible. Set a 7" spike on the W/side.			
Measured		N04°E	33.35'

Yellow Birch	5	S31°E	67½ lks. (44.55')
Presently alive and 5" in diameter having no blazes yet scribing is visible in the bark. Set a 7" spike on the SW/side.			
Measured		S30°E	44.55'

Maple	15	S76°W	87½ lks. (57.75')
Found an alive sugar maple 17" in diameter having a partially healed lower blaze with scribing visible. Set a 7" spike on the SE/side.			
Measured		S70°W	57.75'

Hemlock	18	N43°W	125 lks. (82.50')
Presently alive and 20" in diameter having a partially healed lower blaze with scribing visible. Set a 7" spike on the SW/side.			
Measured		N54°W	81.50'

To each of the above BLM new bearing trees, I added an upper blaze. All blazes as well as a band around the tree at the upper blaze were painted red.

SURVEY &  
REMONUMENTATION

MAY 05 1997

COMMISSION