

**SURVEY & REMONUMENTATION**

MAY 05 1997

**LAND CORNER RECORDATION CERTIFICATE**  
Filing Requirement of Act 74, Mich. P.A. 1970

For corners in

**COMMISSION**

|                                    |                           |               |
|------------------------------------|---------------------------|---------------|
| <u>Baraga</u><br>(County)          | Located In:               | Corner Code # |
| 1. Public Land Survey              | T <u>51N</u> R <u>33W</u> | <u>F-3</u>    |
|                                    | T _____ R _____           | _____         |
|                                    | T _____ R _____           | _____         |
|                                    | T _____ R _____           | _____         |
| 2. Property Controlling in Section | S _____ T _____ R _____   | _____         |
|                                    | S _____ T _____ R _____   | _____         |
| 3. Miscellaneous Property in Sec.  | S _____ T _____ R _____   | _____         |
|                                    | S _____ T _____ R _____   | _____         |

RECEIVED FOR RECORD THIS 23RD DAY OF OCTOBER, 1996 AT 10:30 A.M. AND RECORDED IN LIBER 4 OF LAND CORNER RECORDATION RECORDS ON PAGES 666-667.


*Fields Mc Intyre*  
BARAGA COUNTY REGISTER OF DEEDS

Register of Deeds Stamp & File Number

4. Lot No. \_\_\_\_\_, Recorded Plat \_\_\_\_\_  
5. Private Claims \_\_\_\_\_

I, Michael Mileski, in a field survey on October, 19 96 do hereby state that under requirements of P.A. 74, Michigan P.A. of 1970, the corner points mentioned in lines 1 and 2 above were in conformance with regulations and rules therefore as required in the current manual of survey instructions of the United States Department of the Interior, Bureau of Land Management or by a decree of a Court of Law and for that the corner points mentioned in lines 3, 4 and 5 above were in conformance with the rules of the Michigan Board of Land Surveyors or by a Decree of a Court of Law; established, re-established, monumented, recovered, found as expressed below:

NOTE: Not more than 2 corners, all in the same town and range, may be recorded on this certificate.

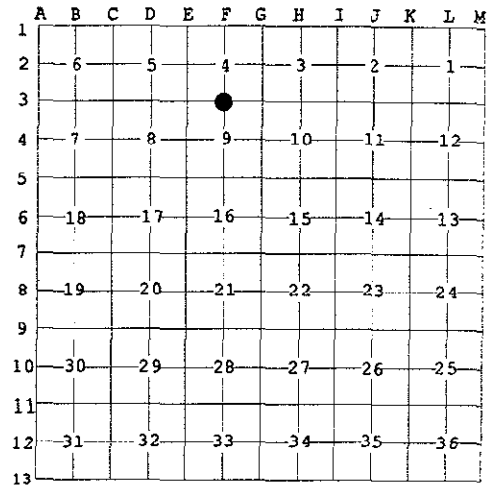

A. Description of original monument and accessories and/or subsequent restoration:

F-3; One-quarter Corner common to Sections 4 and 9, T51N, R33W;

See back of form.

B. Description of corner evidence found and/or method applied in restoring or reestablishing corner:

F-3; One-quarter Corner common to Sections 4 and 9, T51N, R33W;

Found a 2 1/2" x 30" aluminum pipe with a cap as set by the BLM in 1984 in a rock pile 2 feet west of the center of a 10" cedar fence anchor post having fences to the north, east, and south. This monument is located approximately 15 feet north of an east-west, 8 foot wide, woods road. A thorough search for the remains of the U.S. bearing trees proved inconclusive. I did not remonument the corner but added "PA 345 1996" to the cap. Accepted as the best available evidence of the position of the original corner.

C. Description of monument for corner and accessories established to perpetuate locating the position of the corner:

F-3; One-quarter Corner common to Sections 4 and 9, T51N, R33W;

Found a 2 1/2" x 30" aluminum pipe with a 3 1/2" aluminum cap appropriately stamped as to location.

- |                   |         |                 |       |        |
|-------------------|---------|-----------------|-------|--------|
| i) Set 7" spike   | N/side  | 11" Sugar Maple | N52°E | 43.11' |
| ii) Set 7" spike  | SW/side | 16" Sugar Maple | S40°E | 41.84' |
| iii) Set 7" spike | N/side  | 7" Sugar Maple  | S89°W | 34.47' |
| iv) Set 7" spike  | SW/side | 14" Sugar Maple | N33°W | 50.46' |
|                   |         | Location Post   | North | 3.0'   |

(ii) and (iv) are BLM new bearing trees and are further described in Part A.

(i) and (iii) are marked with upper and lower blazes. The lower blaze is scribed "NBT". Both blazes as well as a band around the tree at the upper blaze are painted red.



Signed by Michael Mileski  
Surveyor's Michigan License No. 39091

Date 22 Oct 1996

A. Description of original monument and accessories and/or subsequent restoration:

F-3; One-quarter Corner common to Sections 4 and 9, T51N, R33W;

Originally established during U.S. Survey conducted by Harvey Mellen, D.S. in 1845 and monumented with a sugar maple post witnessed by a

Sugar 16 S18°W 10 lks.

and a

Yellow Birch 12 N54°E 24 lks.

During the course of a survey conducted by Stephen Douglas of the Bureau of Land Management from 10 May 1984 to 10 November 1984 and approved 23 September 1985, this corner was found to be "monumented with a mound of stone, 12 ins. diam., 5 ins. high alongside a fence cor. with fences extending N., E. and S.; from which the remains of the orig. bearing trees: A stump hole, bears N.54°E., 24 lks. dist. (and) A stump hole, bears S.18°W., 10 lks. dist.". The BLM set a 2½" x 30" aluminum pipe with a cap in a "collar of stone" and noted the following new bearing trees:

Sugar Maple 12 S35°E 64 lks. (42.24')  
Presently alive and 16" in diameter having a partially open lower blaze with scribing visible.  
Set 7" spike SW/side S40°E 41.84'

and a

Sugar Maple 10 N28°W 77 lks. (50.82')  
Presently alive and 14" in diameter having a mostly open lower blaze with scribing visible.  
Set 7" spike SW/side N33°W 50.46'

To each of the above BLM new bearing trees I added an upper blaze and painted both blazes red as well as a red band around the tree at the upper blaze.

SURVEY &  
REMONUMENTATION

MAY 05 1997

COMMISSION