

APR 08 1996

COMMISSION

LAND CORNER RECORDATION CERTIFICATE
Filing Requirement of Act 74, Mich. P.A. 1970

For corners in Baraga
(County)

Located In:

Corner Code #

1. Public Land Survey

T 51N R 32W
T 51N R 33W
T _____ R _____
T _____ R _____
S _____ T _____ R _____
S _____ T _____ R _____
S _____ T _____ R _____
S _____ T _____ R _____

A-13
M-13

RECEIVED FOR RECORD THIS 28TH DAY OF DECEMBER A.D. 1995 AT 10:30 A.M. AND RECORDED IN LIBER 4 OF LAND CORNER RECORDATION ON PAGES 615 - 616.

Hilda J. Rohlfen

BARAGA COUNTY REGISTER OF DEEDS

Register of Deeds Stamp & File Number

4. Lot No. _____, Recorded Plat _____
5. Private Claims _____

I, Michael Mileski, in a field survey on December, 1995

do hereby certify that under requirements of P.A. 74, Michigan P.A. of 1970, the corner points mentioned in lines 1 and 2 above were in conformance with regulations and rules therefore as required in the current manual of survey instructions of the United States Department of the Interior, Bureau of Land Management or by a decree of a Court of Law and/or that the corner points mentioned in lines 3, 4 and 5 above were in conformance with the rules of the Michigan Board of Professional Surveyors or by a Decree of a Court of Law; established, re-established, monumented, re-monumented, recovered, found as expressed below:

NOTE: Not more than 4 corners, all in the same town and range, may be recorded on this certificate.

	A	B	C	D	E	F	G	H	I	J	K	L
2	6		5		4		3		2			
3												
4	7		8		9		10		11		12	
5												
6	18		17		16		15		14		13	
7												
8	19		20		21		22		23		24	
9												
10	30		29		28		27		26		25	
11												
12	31		32		33		34		35		36	
13												

A. Description of original monument and accessories and/or subsequent restoration:

A-13; M-13; Section Corner Common to Section 31, T51N, R32W, and Section 36, T51N, R33W, on 5th Correction Line.

APPROVED LAND CORNER
P.A. 345 OF 1990
Baraga County
12-19-95

See back of form.

B. Description of corner evidence found and/or method applied in restoring or reestablishing corner:


A-13; M-13; Section Corner Common to Section 31, T51N, R32W, and Section 36, T51N, R33W, on 5th Correction Line.

Found a 1 1/2" iron pipe firmly set projecting 24 inches above ground in reasonable agreement with the cedar U.S. bearing tree the condition of which is described in Part A. Accepted as a careful and faithful perpetuation of the position of the original corner.

C. Description of monument for corner and accessories established to perpetuate locating the position of the corner:

A-13; M-13; Section Corner Common to Section 31, T51N, R32W, and Section 36, T51N, R33W, on 5th Correction Line.

See back of form.

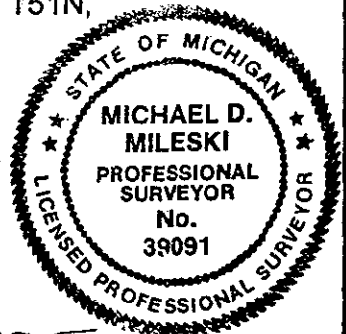

Signed by Michael Mileski

Date 28 Dec 1995

Surveyor's Michigan License No. 39091

FORM APPROVED BY MICHIGAN STATE BOARD OF PROFESSIONAL SURVEYORS, JAN. 28, 1971
REVISED MAY 14, 1975
REVISED JAN., 1983

A. Description of original monument and accessories and/or subsequent restoration:

A-13, M-13; Section Corner common to Section 31, T51N, R32W, and Section 36, T51N, R33W, on 5th Correction Line.

Originally established during U.S. Survey conducted by Austin Burt, D.S. in 1845 and monumented with a wood post witnessed by a

Birch 12 N17°E 4 lks. (Gone)

and a

Cedar 12 N45°W 27 lks.
(Recovered as a fallen partial stump of indeterminate size.)

The following notation can be found in the left margin of page 1 of the transcribed U.S. field notes for T51N, R33W available at the Baraga County Register of Deeds office in L'Anse: "Found both B.T.'s, W.W. Stockly, June 25, 1925, 1¼" gas pipe for cor. post".

This corner was recovered by Stephen Douglas of the Bureau of Land Management during the course of a survey conducted from 13 May 1987 to 4 November 1987 and approved on 24 March 1989. Mr. Douglas did not remonument the corner nor did he note any new bearing trees.

C. Description of monument for corner and accessories established to perpetuate locating the position of the corner:

A-13, M-13; Section Corner common to Section 31, T51N, R32W, and Section 36, T51N, R33W, on 5th Correction Line.

Replaced found 1½" iron pipe with a 1" (I.D.) x 36" galvanized iron pipe with 2" aluminum cap appropriately stamped as to location.

Set 60d spike	S/side	4" Red Maple	S88°E	11.96'
Set 60d spike	W/side	4" Sugar Maple	S03°E	16.30'
Set 60d spike	N/side	4" Sugar Maple	S78°W	7.00'
Set 60d spike	NE/side	5" Sugar Maple	N42°W	4.35'

All of the above new bearing trees marked with upper and lower face blazes and scribed "NBT".