## LAND CORNER RECORDATION CERTIFICATE

**Filing Requirement of Act 74, Mich. P.A. 1970**

For corners in Baraga (County)

| | Located In: | Corner Code # |
|---|---|---|
| 1. Public Land Survey | T 51N R 34W | A13 |
| | T ___ R ___ | |
| | T ___ R ___ | |
| | T ___ R ___ | |
| 2. Property Controlling | S ___ T ___ R ___ | |
| in Section | S ___ T ___ R ___ | |
| 3. Miscellaneous | S ___ T ___ R ___ | |
| Property in Sec. | S ___ T ___ R ___ | |

RECEIVED FOR RECORD THIS 30TH DA' OF DECEMBER A. D. 1993 AT 10:30 A. M. AND RECORDED IN LIBER 4 OF LAND CORNER RECORDATION ON PAGE 473.

BARAGA COUNTY REGISTER OF DEEDS

**Register of Deeds Stamp & File Number**

4. Lot No. _____, Recorded Plat _____
5. Private Claims _____

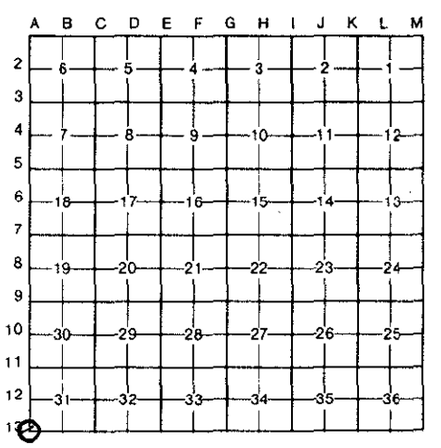


I, Dennis R. Destrampe, in a field survey on December 9, 19 93, do hereby certify that under requirements of P.A. 74, Michigan P.A. of 1970, the corner points mentioned in lines 1 and 2 above were in conformance with regulations and rules therefore as required in the current manual of survey instructions of the United States Department of the Interior, Bureau of Land Management or by a decree of a Court of Law and/or that the corner points mentioned in lines 3, 4 and 5 above were in conformance with the rules of the Michigan Board of Land Surveyors or by a Decree of a Court of Law; established, re-established, monumented, re-monumented, recovered, found as expressed below:

**NOTE: Not more than 4 corners, all in the same town and range, may be recorded on this certificate.**

A. Description of original monument and accessories and/or subsequent restoration:

Wood Post
Hemlock 16 N63E 38
Hemlock 12 N13W 54

Original corner not found. Corner was restored in U.S.F.S. survey recorded in Volume 1 of Plats, January 7, 1964. No L.C.R.C. was found for this corner.

B. Description of corner evidence found and/or method applied in restoring or reestablishing corner:

Found 2" pipe with 3" brass cap, 1.5 feet above ground.
Cap reads:

SC
T51N
R35W | R34W
S36 | S31
T50N R35W
S4

RLS 1961 12585

SURVEY & REMONUMENTATION

MAY 17 1994

COMMISSION

C. Description of monument for corner and accessories established to perpetuate locating the position of the corner:

Corner accepted as found

| | | | | |
|---|---|---|---|---|
| Witnesses: | 11" Maple | N57E | 8.21' | (8d nail found) |
| | 7" Maple | S30W | 30.72' | (Nail & tag "UPEA 18983" set) |
| | 10" Maple | N69W | 32.80' | (8d nail found) |
| | 9" Maple | N26W | 25.38' | (8d nail found) |

STATE OF MICHIGAN
DENNIS R. DESTRAMPE
SURVEYOR
No. 18983
PROFESSIONAL SURVEYOR

Signed by Dennis R. Destrampe Date December 27, 1993

Surveyor's Michigan License No. 18983

FORM APPROVED BY MICHIGAN STATE BOARD OF LAND SURVEYORS, JAN. 28, 1971
REVISED MAY 14, 1975
REVISED JAN., 1983