

**SURVEY & REMONUMENTATION**

MAY 17 1994

COMMISSION

**LAND CORNER RECORDATION CERTIFICATE**  
**Filing Requirement of Act 74, Mich. P.A. 1970**

For corners in

Baraga

(County)

Located In:

Corner Code #

- |                                    |               |               |             |
|------------------------------------|---------------|---------------|-------------|
| 1. Public Land Survey              | T <u>51</u> N | R <u>34</u> W | <u>C-13</u> |
|                                    | T _____       | R _____       | _____       |
|                                    | T _____       | R _____       | _____       |
|                                    | T _____       | R _____       | _____       |
| 2. Property Controlling in Section | S _____       | T _____       | R _____     |
|                                    | S _____       | T _____       | R _____     |
| 3. Miscellaneous Property in Sec.  | S _____       | T _____       | R _____     |
|                                    | S _____       | T _____       | R _____     |
4. Lot No. \_\_\_\_\_, Recorded Plat \_\_\_\_\_
5. Private Claims \_\_\_\_\_

RECEIVED FOR RECORD THIS 30TH DA OF DECEMBER A. D. 1993 AT 10:30 A. M. AND RECORDED IN LIBER 4 OF LAND CORNER RECORDATION ON PAGE 465.

*Dennis R. Destrampe*  
 BARAGA COUNTY REGISTER OF DEEDS  
 Register of Deeds Stamp & File Number

	A	B	C	D	E	F	G	H	I	J	K	L	M
2	6	5	4	3	2								
3													
4	7	8	9	10	11	12							
5													
6	18	17	16	15	14	13							
7													
8	19	20	21	22	23	24							
9													
10	30	29	28	27	26	25							
11													
12	31	32	33	34	35	36							
13													

I, Dennis R. Destrampe, in a field survey on December 13, 19 93, do hereby certify that under requirements of P.A. 74, Michigan P.A. of 1970, the corner points mentioned in lines 1 and 2 above were in conformance with regulations and rules therefore as required in the current manual of survey instructions of the United States Department of the Interior, Bureau of Land Management or by a decree of a Court of Law and/or that the corner points mentioned in lines 3, 4 and 5 above were in conformance with the rules of the Michigan Board of Land Surveyors or by a Decree of a Court of Law; established, re-established, monumented, re-monumented, recovered, found as expressed below:


**NOTE: Not more than 4 corners, all in the same town and range, may be recorded on this certificate.**

**A. Description of original monument and accessories and/or subsequent restoration:**

Wood Post Corner restored November 9, 1961 and recorded April 13, 1964  
 Spruce 10 N59E 31 in Book 2, Index Z-5, Page 20. Perpetuated and recorded in  
 Spruce 6 N55W 15 Liber 4, Page 50 of L.C.R.C. on June 8, 1982.

**B. Description of corner evidence found and/or method applied in restoring or reestablishing corner:**

Found corner as described in Liber 4, Page 50, lying several feet from record location; appears to have been disturbed by road grading operations. Reset corner from ties. Distances to east and west checked with U.S.F.S. survey recorded in Volume 1 of Plats, January 7, 1964. Set a 1" by 36" pipe with a 2½" brass cap 7" below surface of gravel road.

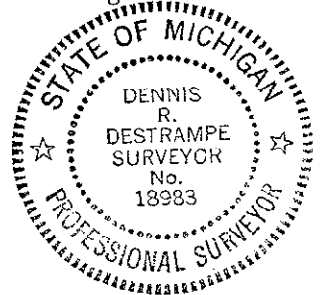

**C. Description of monument for corner and accessories established to perpetuate locating the position of the corner:**

1"X36" pipe with a 2½" brass cap 7" below surface of gravel road. Brass cap stamped BARAGA CTY. REMONUMENTATION, T51N, R34W, SC, 1993

S31 | S32

Witnesses: Witness Monument N88W 15.00 (2½" pipe with 3" brass cap - U.S.F.S.)  
 3" Elm N48W 12.71' (Nail & tag "UPEA 18983" set)  
 10" Spruce N67E 69.26' (PK nail found)  
 24" Twin Maple S80E 86.17' (PK nail w/tag found)

Signed by Dennis R. Destrampe  
 Surveyor's Michigan License No. 18983

Date December 27, 1993