

**SURVEY &
REMONUMENTATION**

MAY 17 1994

COMMISSION

**LAND CORNER RECORDATION CERTIFICATE
Filing Requirement of Act 74, Mich. P.A. 1970**

For corners in
Baraga

(County)

Located In:

Corner Code #

1. Public Land Survey	T <u>51N</u> R <u>34W</u>	<u>D-13</u>
	T _____ R _____	_____
	T _____ R _____	_____
	T _____ R _____	_____
2. Property Controlling in Section	S _____ T _____ R _____	_____
	S _____ T _____ R _____	_____
3. Miscellaneous Property in Sec.	S _____ T _____ R _____	_____
	S _____ T _____ R _____	_____

RECEIVED FOR RECORD THIS 30TH DAY
OF DECEMBER A. D. 1993 AT 10:30
A. M. AND RECORDED IN LIBER 4 OF
LAND CORNER RECORDATION ON PAGE
466.

Dennis R. Destrampe
BARAGA COUNTY REGISTER OF DEEDS
Register of Deeds Stamp & File Number

4. Lot No. _____, Recorded Plat _____
5. Private Claims _____

I, Dennis R. Destrampe in a field survey on December 9, 19 93,
do hereby certify that under requirements of P.A. 74, Michigan P.A. of 1970, the corner points mentioned
in lines 1 and 2 above were in conformance with regulations and rules therefore as required in the
current manual of survey instructions of the United States Department of the Interior, Bureau of Land
Management or by a decree of a Court of Law and/or that the corner points mentioned in lines 3, 4 and 5
above were in conformance with the rules of the Michigan Board of Land Surveyors or by a Decree of a
Court of Law; established, re-established, monumented, re-monumented, recovered, found as
expressed below:


**NOTE: Not more than 4 corners, all in the same town and range, may be recorded
on this certificate.**

	A	B	C	D	E	F	G	H	I	J	K	L	M
2	6		5		4		3		2		1		
3													
4	7		8		9		10		11		12		
5													
6	18		17		16		15		14		13		
7													
8	19		20		21		22		23		24		
9													
10	30		29		28		27		26		25		
11													
12	31		32		33		34		35		36		
13													

A. Description of original monument and accessories and/or subsequent restoration:
Wood Post Original corner not found. Corner was restored November 8, 1961
Hemlock 10 N63E 10 and recorded April 13, 1964, Book 2, Index No. Z-7, Page 21
Hemlock 12 N61W 36

B. Description of corner evidence found and/or method applied in restoring or reestablishing corner:
Corner found as described in Book 2, Index No. Z-7, Page 21:

2" pipe with 3" brass cap 1.6 feet above ground.
Cap reads T51N., R34W., S.C. ¼, S-32 1961

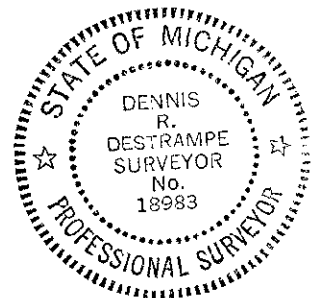

C. Description of monument for corner and accessories established to perpetuate locating the position of the corner:
Corner accepted as found

Witnesses: 11" Spruce N53E 44.14' (Nail & tag "UPEA 18983" set)(USFS BT)
7" Maple S24E 20.00' (Nail & tag "UPEA 18983" set)
7" Maple N64W 35.91' (Nail & tag "UPEA 18983" set)(USFS BT)
6" Spruce N18W 25.82' (Nail & tag "UPEA 18983" set)(USFS BT)

Signed by Dennis R. Destrampe Date December 22, 1993
Surveyor's Michigan License No. 18983