

MAY 17 1994

COMMISSION

LAND CORNER RECORDATION CERTIFICATE
Filing Requirement of Act 74, Mich. P.A. 1970

For corners in

Baraga (County)	Located In:	Corner Code #
1. Public Land Survey	T 51N R 34W	E-13
	T _____ R _____	_____
	T _____ R _____	_____
	T _____ R _____	_____
2. Property Controlling in Section	S _____ T _____ R _____	_____
	S _____ T _____ R _____	_____
3. Miscellaneous Property in Sec.	S _____ T _____ R _____	_____
	S _____ T _____ R _____	_____

RECEIVED FOR RECORD THIS 30TH DAY
OF DECEMBER A. D. 1993 AT 10:30
A. M. AND RECORDED IN LIBER 4 OF
LAND CORNER RECORDATION ON PAGE
471.

Hilda J. Robillard
BARAGA COUNTY REGISTER OF DEEDS
Register of Deeds Stamp & File Number


4. Lot No. _____, Recorded Plat _____
5. Private Claims _____

I, Dennis R. Destrampe, in a field survey on December 9, 1993
do hereby certify that under requirements of P.A. 74, Michigan P.A. of 1970, the corner points mentioned
in lines 1 and 2 above were in conformance with regulations and rules therefore as required in the
current manual of survey instructions of the United States Department of the Interior, Bureau of Land
Management or by a decree of a Court of Law and/or that the corner points mentioned in lines 3, 4 and 5
above were in conformance with the rules of the Michigan Board of Land Surveyors or by a Decree of a
Court of Law; established, re-established, monumented, re-monumented, recovered, found as
expressed below:


**NOTE: Not more than 4 corners, all in the same town and range, may be recorded
on this certificate.**

A. Description of original monument and accessories and/or subsequent restoration:
8" Cedar Original corner not found. Corner was restored in U.S.F.S.
Cedar 14 N70W 11 survey recorded in Volume 1 of Plats, January 7, 1964.
No L.C.R.C. was found for this corner.

B. Description of corner evidence found and/or method applied in restoring or reestablishing corner:
Found 2" pipe with 3" brass cap 1.4 feet above ground.
Cap reads:

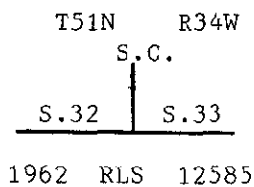

	A	B	C	D	E	F	G	H	I	J	K	L	M
2	6	5	4	3	2	1							
3													
4	7	8	9	10	11	12							
5													
6	18	7	16	15	14	13							
7													
8	19	20	21	22	23	24							
9													
10	30	29	28	27	26	25							
11													
12	31	32	33	34	35	36							
13													

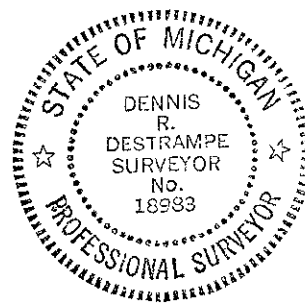

C. Description of monument for corner and accessories established to perpetuate locating the position of the corner:
Corner accepted as found.

Witnesses: 7" Maple N02E 22.05' (Nail & tag "UPEA 18983" set)
7" Maple N80E 12.96' (Nail & tag "UPEA 18983" set)(USFS BT)
7" Maple S19E 20.55' (Nail & tag "UPEA 18983" set)
7" Maple N46W 17.10' (Nail & tag "UPEA 18983" set)(USFS BT)

Signed by Dennis R. Destrampe Date December 27, 1993
Surveyor's Michigan License No. 18983