SURVEY &
REMONUMENTATION

MAY 17 1994

COMMISSION

LAND CORNER RECORDATION CERTIFICATE

Filing Requirement of Act 74, Mich. P.A. 1970

For corners in
Baraga
(County)

	Located In:	Corner Code #
1. Public Land Survey	T 51N R 34W	H-13
	T ___ R ___	
	T ___ R ___	
	T ___ R ___	
2. Property Controlling	S ___ T ___ R ___	
in Section	S ___ T ___ R ___	
3. Miscellaneous	S ___ T ___ R ___	
Property in Sec.	S ___ T ___ R ___	

RECEIVED FOR RECORD THIS 30TH D
OF DECEMBER A. D. 1993 AT 10:30
A. M. AND RECORDED IN LIBER 4 0
LAND CORNER RECORDATION ON PAGE
462.

BARAGA COUNTY REGISTER OF DEEDS

Register of Deeds Stamp & File Number

4. Lot No. _____ , Recorded Plat _____
5. Private Claims _____

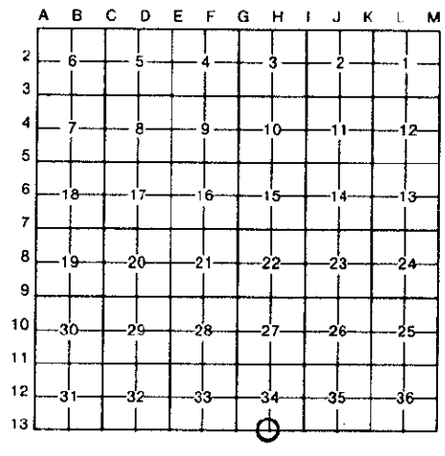

I, Dennis R. Destrampe, in a field survey on December 17, 19 93, do hereby certify that under requirements of P.A. 74, Michigan P.A. of 1970, the corner points mentioned in lines 1 and 2 above were in conformance with regulations and rules therefore as required in the current manual of survey instructions of the United States Department of the Interior, Bureau of Land Management or by a decree of a Court of Law and/or that the corner points mentioned in lines 3, 4 and 5 above were in conformance with the rules of the Michigan Board of Land Surveyors or by a Decree of a Court of Law; established, re-established, monumented, re-monumented, recovered, found as expressed below:

NOTE: Not more than 4 corners, all in the same town and range, may be recorded on this certificate.

A. Description of original monument and accessories and/or subsequent restoration:

Wood Post
Hemlock 8 N37E 43
Do 8 N58W 40

Original corner not found. No record of subsequent restoration.

B. Description of corner evidence found and/or method applied in restoring or reestablishing corner:

No evidence found of original corner or subsequent restoration. Traverse was run from standard corner at SW corner of Section 36, T51N, R34W to the standard corner at SW corner of Section 34, T51N, R34W; corner was set by single proportionate method.

STATE OF MICHIGAN
DENNIS R. DESTRAMPE SURVEYOR No. 18983
PROFESSIONAL SURVEYOR

C. Description of monument for corner and accessories established to perpetuate locating the position of the corner:

Set 1"X36" pipe with 2½" brass cap 0.8 feet above ground. Brass cap stamped:

BARAGA CTY. REMONUMENTATION
S.C.
T51N R34W
1/4 ● S34
1993

Witnesses:
6" Ironwood N56E 51.13' (Nail & tag "UPEA 18983" set)
5" Ironwood N32E 58.84' (Nail & tag "UPEA 18983" set)
9" Aspen N14W 40.96' (Nail & tag "UPEA 18983" set)
3/4" Iron Pin S55E 13.94'

Signed by Dennis R. Destrampe Date December 30, 1993

Surveyor's Michigan License No. 18983

FORM APPROVED BY MICHIGAN STATE BOARD OF LAND SURVEYORS, JAN. 28, 1971
REVISED MAY 14, 1975
REVISED JAN., 1983