

MAY 17 1994

COMMISSION

LAND CORNER RECORDATION CERTIFICATE
Filing Requirement of Act 74, Mich. P.A. 1970

For corners in

Table with columns: Baraga (County), Located In, Corner Code #. Rows include Public Land Survey, Property Controlling in Section, and Miscellaneous Property in Sec.

RECEIVED FOR RECORD THIS 30TH D OF DECEMBER A. D. 1993 AT 10:30 A. M. AND RECORDED IN LIBER 4 0 LAND CORNER RECORDATION ON PAGE 461

Handwritten signature of the Register of Deeds

BARAGA COUNTY REGISTER OF DEEDS

Register of Deeds Stamp & File Number

- 4. Lot No. , Recorded Plat
5. Private Claims

Grid table with columns A-M and rows 2-13. A circled '1' is present in row 13, column M.

I, Dennis R. Destrampe in a field survey on December 17, 1993, do hereby certify that under requirements of P.A. 74, Michigan P.A. of 1970, the corner points mentioned in lines 1 and 2 above were in conformance with regulations and rules therefore as required in the current manual of survey instructions of the United States Department of the Interior, Bureau of Land Management or by a decree of a Court of Law and/or that the corner points mentioned in lines 3, 4 and 5 above were in conformance with the rules of the Michigan Board of Land Surveyors or by a Decree of a Court of Law; established, re-established, monumented, re-monumented, recovered, found as expressed below.


NOTE: Not more than 4 corners, all in the same town and range, may be recorded on this certificate.

A. Description of original monument and accessories and/or subsequent restoration:

Wood Post Original corner not found. No record of subsequent restoration.
Cedar 12 N74E 13
Do 8 N48W 21

B. Description of corner evidence found and/or method applied in restoring or reestablishing corner:

No evidence found of original corner or subsequent restoration. Traverse was run from the standard corner at SW corner of Section 36, T51N, R34W to the standard corner at SW corner of Section 34, T51N, R34W; corner was set by single proportionate method.

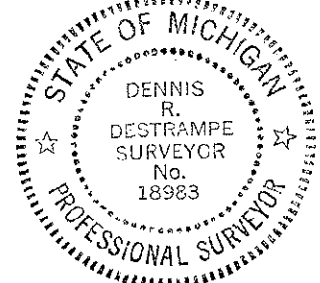

C. Description of monument for corner and accessories established to perpetuate locating the position of the corner:

Set 1"X36" pipe with 2 1/2" brass cap 0.8 feet above ground. Brass cap stamped:

BARAGA CTY. REMONUMENTATION

Witnesses: 9" Cedar N22E 26.63' (Nail & tag "UPEA 18983" set)
11" Maple S48E 29.21' (Nail & tag "UPEA 18983" set)
13" Maple S27W 23.51' (Nail & tag "UPEA 18983" set)
8" Cedar S72W 18.71' (Nail & tag "UPEA 18983" set)

S. 5
1993

Signed by Dennis R. Destrampe
Surveyor's Michigan License No. 18983

Date December 30, 1993