

SURVEY & REMONUMENTATION

MAY 17 1994

COMMISSION

LAND CORNER RECORDATION CERTIFICATE
Filing Requirement of Act 74, Mich. P.A. 1970

For corners in

<u>Baraga</u> (County)	Located In:	Corner Code #
1. Public Land Survey	T <u>51N</u> R <u>34W</u>	<u>K-13</u>
	T _____ R _____	_____
	T _____ R _____	_____
	T _____ R _____	_____
2. Property Controlling in Section	S _____ T _____ R _____	_____
	S _____ T _____ R _____	_____
3. Miscellaneous Property in Sec.	S _____ T _____ R _____	_____
	S _____ T _____ R _____	_____
4. Lot No. _____, Recorded Plat _____		
5. Private Claims _____		

RECEIVED FOR RECORD THIS 30TH DAY OF DECEMBER A. D. 1993 AT 10:30 A. M. AND RECORDED IN LIBER 4 OF LAND CORNER RECORDATION ON PAGE 472.

Hilda J. Robillard
 BARAGA COUNTY REGISTER OF DEEDS
 Register of Deeds Stamp & File Number

I, Dennis R. Destrampe, in a field survey on December 16, 19 93, do hereby certify that under requirements of P.A. 74, Michigan P.A. of 1970, the corner points mentioned in lines 1 and 2 above were in conformance with regulations and rules therefore as required in the current manual of survey instructions of the United States Department of the Interior, Bureau of Land Management or by a decree of a Court of Law and/or that the corner points mentioned in lines 3, 4 and 5 above were in conformance with the rules of the Michigan Board of Land Surveyors or by a Decree of a Court of Law; established, re-established, monumented, re-monumented, recovered, found as expressed below:

NOTE: Not more than 4 corners, all in the same town and range, may be recorded on this certificate.


	A	B	C	D	E	F	G	H	I	J	K	L	M
2	6	5	4	3	2	1							
3													
4	7	8	9	10	11	12							
5													
6	18	17	16	15	14	13							
7													
8	19	20	21	22	23	24							
9													
10	30	29	28	27	26	25							
11													
12	31	32	33	34	35	36							
13													

A. Description of original monument and accessories and/or subsequent restoration:

Wood Post Original corner not found. No record of subsequent restoration.
 Hemlock 8 N68E 14
 Hemlock 14 N13W 9

B. Description of corner evidence found and/or method applied in restoring or reestablishing corner:

Found 1/2" iron pin below grade in gravel road. Found witnesses with nail & tag "SCH LS 32336". Checked with S.C.H., he had found pin, but did not record as he did not have enough evidence. Traversed to corners east and west, line and distance fit with G.L.O. distances. Corner accepted as found.

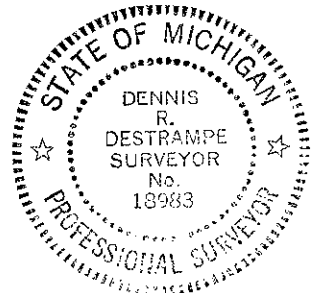

C. Description of monument for corner and accessories established to perpetuate locating the position of the corner:

Replaced 1/2" iron pin with 1"X36" pipe with 2 1/2" brass cap 6" below surface of gravel road. Brass cap stamped BARAGA CTY. REMONUMENTATION, T51N, R34W, S.C., 1993

S.35 | S.36

Witnesses: 5" Poplar N52W 81.25' (Nail & tag "SCH LS 32336" found)
 6" W. Ash N01W 38.45' (Nail & tag "SCH LS 32336" found)
 6" Poplar N50E 52.96' (Nail & tag "SCH LS 32336" found)
 Power Pole S60E 52.88' (Nail & tag "SCH LS 32336" found)

Signed by Dennis R. Destrampe Date December 28, 1993
 Surveyor's Michigan License No. 18983