LAND CORNER RECORDATION CERTIFICATE
Filing Requirement of Act 74, Mich. P.A. 1970 as Amended

For corners in

Baraga
(County)

	Located In:	Corner Code #
1. Public Land Survey	T 52N R 30W	C11
	T___ R___	
	T___ R___	
	S___ T___ R___	
2. Property Controlling	S___ T___ R___	
in Section	S___ T___ R___	
3. Miscellaneous	S___ T___ R___	
Property in Sec.	S___ T___ R___	

Register of Deeds Stamp & File Number

4. Lot No. _____ , Recorded Plat_____
5. Private Claims

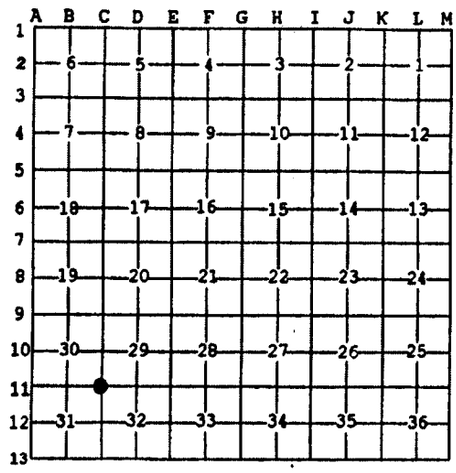

Jun 23 2005

I, Stephan J. Szyszkoski, in a field survey on _____, 20 ____ do hereby state that under requirements of P.A. 74, Michigan P.A. of 1970, the corner points mentioned in lines 1 and 2 above were in conformance with regulations and rules therefore as required in the current manual of survey instructions of the United States Department of the Interior, Bureau of Land Management or by a decree of a Court of Law and /or that the corner points mentioned in lines 3, 4 and 5 above were in conformance with the rules of the Michigan Board of Land Surveyors or by a Decree of a Court of Law; established, re-established, monumented, recovered, found as expressed below:

NOTE: Not more than 2 corners, all in the same town and range, may be recorded on this certificate.

A. Description of original monument and accessories and/or subsequent restoration:

(C11) Corner common to Sections 29-30-31-32. 1846 - Established by Wm. Ives, Deputy Surveyor: North between Sections 31&32 ...80.00 Set post corner of Sections 29-30-31-32. Y.Birch 14 S73W 29 links, Maple 15 N9E 28 links. Circa 1929 Michigan Dept. of State Highway topographic notes for STL 35-10 (now Skanee Rd.) show Station 945+32, 16' L of C/L "approx. Sec Cor." 1965 - F.J.Bray, RLS states in LCR recorded L2, P301 that he set corner C12 midway between Section corners. 2000 - Eric Tiahrt, PS 46693 reestablished C11 by double proportionate measurement to the original record between corners C9, C12, B11, and I11. Set 5/8" iron with JCK cap #24598 approx. 10' south of C/L Skanee Road and approx. 20' west of an old fence running south. LCR recorded L5, P216, Baraga County Records.

B. Description of corner evidence found and/or method applied in restoring or reestablishing corner:

(C11) The original post and accessories were not recovered. Found no evidence of the MDSH approximate corner position. Found, but did not accept the 2000 monument of record. I reestablished the corner position in the center of the pavement of Skanee Road at its intersection with a straight line through monuments of record at corners C13 and C12. The position thus reestablished falls on the S'ly extension of an old fence line to the north. I did not find an old fence line to the south, as noted in the 2000 record. Using the position thus reestablished the 1965 monument at C12 is 2.19' north of midway between C11 and C13. The reestablished position is 5396.782' east of corner A11 (MDSH record from A11 to "approximate" C11 was 5397.2'. The 2000 monument was left in place, being S67W 25.8' distant.

C. Description of monument for corner and accessories established to perpetuate locating the position of the corner:

(C11) Set 1"IDx32" I.pipe with 4" alum.
MDNR cap 6" below asphalt surface of
Skanee Rd. Set measuring nails in:
10" Maple S25E 39.7' mrkd "S32 NBT" *
11" Hemlock S52W 56.9' "S31 NBT" *
6" Sugar N09W 57.2' "S30 NBT"
Power pole N79E 118.8'
Bearings are magnetic. Distances are to
nail with MDNR tag. * denotes 2000 NBT
of record re-marked and scribed to face
corner.

STATE OF MICHIGAN
STEPHAN J. SZYSZKOSKI
LAND SURVEYOR
No. 33986
LICENSED LAND SURVEYOR

Signed by Stephen J. Szyszkoski Date 11/22/05

Surveyor's Michigan License No. 33986

For the Michigan Department of Natural Resources, Office of Land and Facilities

FORM APPROVED BY MICHIGAN STATE BOARD OF PROFESSIONAL SURVEYORS, JAN. 28, 19
Revised May 14, 19
Revised Jan., 19
Rervised Oct., 19