

LAND CORNER RECORDATION CERTIFICATE

FILING REQUIREMENT OF ACT 74, MICH. P.A.1970

FOR CORNERS OF--:	LOCATED IN--:	CORNER CODE NUMBER
1. PUBLIC LAND SURVEY _____	T. <u>52</u> N. <u>33</u> E. <u>W.</u>	<u>A3; A5; and C5</u>
2. PROPERTY CONTROLLING IN SECTION _____	T. _____ N. _____ E. _____ S. _____ R. _____ W. _____	_____
3. MISCELLANEOUS PROPERTY IN SECTION _____	T. _____ N. _____ E. _____ S. _____ R. _____ W. _____	_____
4. LOT NO. _____, RECORDED PLAT _____		
5. PRIVATE CLAIMS _____		

REGISTER OF DEEDS STAMP AND FILING NUMBER

I, Arthur O. Enger do hereby certify that under requirements of P.A. 74, Michigan P.A. of 1970, the corner points mentioned in lines 1 and 2 above (identified with circles on index code diagram—over) were, in a field survey on see below 19____, established, re-established, monumented, re-monumented, recovered or restored as expressed below and in conformance with regulations and rules therefore as required in the current manual of survey instructions of the United States Department of the Interior, Bureau of Land Management or by a decree of a court of law. Furthermore, that the corner points mentioned in lines 3, 4 and 5 above were, in a field survey on _____ 19____, found, recovered, restored, established or re-established as expressed below and in conformance with the rules of the Michigan State Board of Registration for Land Surveyors or, by a Decree of a Court of law:

A. Description of original monument and accessories and/or subsequent restoration:

Found no evidence at any of these corners of the original posts or their accessories. Found a 1"x24" iron pin in place at Corner A3; roads and fence lines offered collateral evidence of positions of Corners A5 and C5, but no monuments were found.

B. Description of corner evidence found and/or method applied in restoring or re-establishing corner:

Corner A3: Replaced the found iron pin on 4/12/73 with a new monument described below. The pin was found about midway between old fence lines paralleling a portion of a former county road, at a distance from property fence lines to E consistent with the original survey record, and from a road intersection 1 mile S whose distance is also consistent with the record. Not known who placed the pin.

Corner A5: Re-established on 4/13/73 at intersection of approximate construction centerlines of a N & S county road and a county road going W, which are presumed to be the section lines by common report.

Corner C5: Re-established on 5/29/73 in center of N & S county road and in line with old fences to E and to W. Distance W to Corner A5 is calculated by traverse to be 5408.3 ft., the original record

C. Description of monument for corner and accessories established to perpetuate locating the position of the corner:

- Monuments for Corners A3 and C5: 1" I.D. x 36" iron pipe with 4" aluminum cap.
- Monument for Corner A5: 1" I.D. x 24" iron pipe with 4" aluminum cap. All buried in roadbed.
- Witnesses for Corner A3: PK nail in fence corner post N46°W (mag.) 20.90 ft.
PK nail in Box elder 12 N25°E (mag.) 35.90 ft.
- Witnesses for Corner A5: Nail in Power Pole S62°W (mag.) 66.19 ft.
Stop sign post S16°E (mag.) 44.3 ft.
Telephone jct. box N36°W (mag.) 94.0 ft.
- Witnesses for Corner C5: Cedar 4 N47°E (mag.) 22.5 ft. "S8, NBT"
Cedar 4 S61°E (mag.) 25.1 ft. "S17, NBT"
Balsam 6 S38°W (mag.) 32.5 ft. "S18, NBT"

SIGNED BY _____ DATE _____

SURVEYOR'S MICHIGAN REGISTRATION NO. _____ (SEAL)

FOR STATE AND UNITED STATES AGENCIES:

SIGNED BY _____ DATE December 28, 1973


APPROVED AND SIGNED BY Arthur O. Enger DATE December 28, 1973
MICHIGAN REGISTERED LAND SURVEYOR (SEAL)

Michigan Department of Natural Resources

SURVEYOR'S MICHIGAN REGISTRATION NO. 13581


CORNER NUMBERING CODE DIAGRAMS FOR IDENTIFYING LAND CORNER RECORDATIONS AND INDEXING

**FOR PUBLIC LAND SURVEY CORNERS IN THE
T. 52N, R. 33W (MENTIONED OVER)**

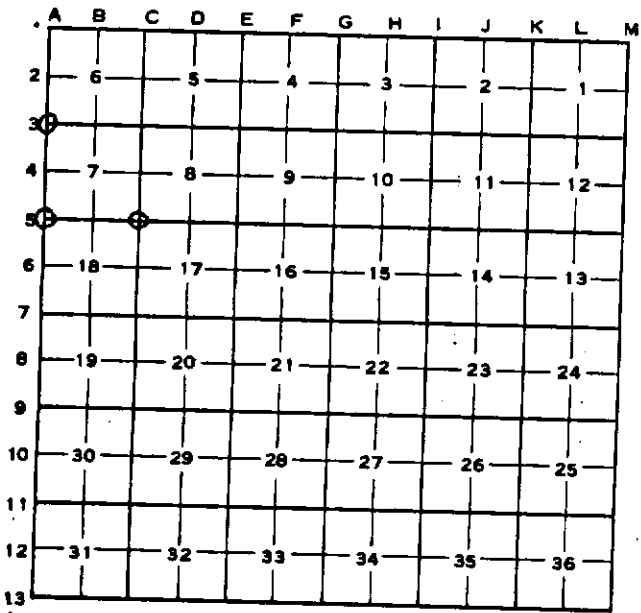

Apply letter prefix for corner points encircled above for identifying corner recordation numbers over.

FOR PROPERTY CONTROLLING AND MISC. PROPERTY CORNERS WITHIN THE SECTION (MENTIONED OVER AND EXCLUDE LOT CORNER)

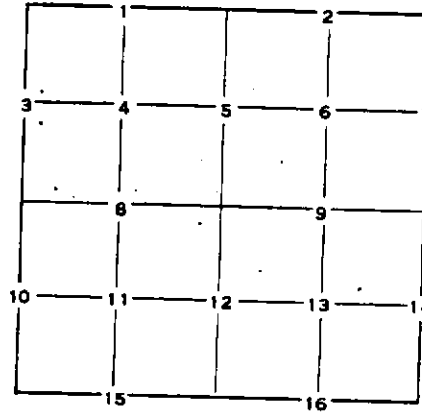

1. Above coded numbers are positioned on 1/16 fractional lines of the section.
2. Township corner code numbers shall be applied to corners of above typical section not numbered.
3. Miscellaneous property corners within a section, located at points other than numbered above, shall be referenced to at least two of above corner code numbers.
4. Private claim corners to be tied to rectangular land corners if possible - sketch required below.

EXPLANATORY SKETCH IF NECESSARY -- BELOW

