

LAND CORNER RECORDATION CERTIFICATE

FILING REQUIREMENT OF ACT 74, MICH. P.A.1970

FOR CORNERS OF--:	LOCATED IN--:	CORNER CODE NUMBER
1. PUBLIC LAND SURVEY _____	T. <u>52</u> ^{N.} XX , R. <u>33</u> ^{XXX} W.	D3
2. PROPERTY CONTROLL- ING IN SECTION <u>6</u>	, T. <u>52</u> ^{N.} XX , R. <u>33</u> ^{XXX} W.	15
3. MISCELLANEOUS PROPERTY IN SECTION _____	, T. _____ ^{N.} _____, R. _____ ^{E.} _____ W.	
4. LOT NO. _____, RECORDED PLAT _____		
5. PRIVATE CLAIMS _____		

REGISTER OF DEEDS STAMP AND
FILING NUMBER

I, Arthur O. Enger do hereby certify that under requirements of P.A. 74, Michigan P.A. of 1970, the corner points mentioned in lines 1 and 2 above (identified with circles on index code diagram - over) were, in a field survey on April 13 1973, established, re-established, monumented, re-monumented, recovered or restored as expressed below and in conformance with regulations and rules therefore as required in the current manual of survey instructions of the United States Department of the Interior, Bureau of Land Management or by a decree of a court of law. Furthermore, that the corner points mentioned in lines 3, 4 and 5 above were, in a field survey on _____ 19____, found, recovered, restored, established or re-established as expressed below and in conformance with the rules of the Michigan State Board of Registration for Land Surveyors or, by a Decree of a Court of law:

A. Description of original monument and accessories and/or subsequent restoration:
Corner D3: No evidence of original post or its accessories. No subsequent monuments found, except as inferred from road and fence lines.

Corner 15: Probably was once established, at least by approximation; found a 1" I.D. iron pipe N84°E 12.65 ft. from corner reported herein.

B. Description of corner evidence found and/or method applied in restoring or re-establishing corner:
Corner D3: Corner re-established 33 ft. W of, and in line with, fence corner and old fence line to E, which places it nearly at the intersection of construction centerlines of county roads to S and to W. Distance W to twp. boundary is 8,033.0 ft., original record distance is 8,031.5 ft.
Corner 15: Established proportionately on line between 1/4 cor. 1319.5 ft. E and Sec. Cor. 1436.9 ft. W.

C. Description of monument for corner and accessories established to perpetuate locating the position of the corner:
Corner D3: 1" I.D. x 36" iron pipe with 4" aluminum cap.
 B. Ash 10 S22°W (mag.) 109.2 ft. "1/4S, NBT"
 Y. Birch 9 S52°E (mag.) 40.9 ft. "1/4S, NBT"
Corner 15: 1" I.D. x 24" iron pipe with 4" aluminum cap, buried in road.
 B. Ash 3 N58°E (mag.) 19.83 ft. to nail in tree.
 Fence post S2°E (mag.) 30.75 ft. to nail in post.

SIGNED BY _____ DATE _____

SURVEYOR'S MICHIGAN REGISTRATION NO. _____ (SEAL)

FOR STATE AND UNITED STATES AGENCIES:

SIGNED BY Keith L. Sackett CHIEF OF SURVEY PARTY DATE December 28, 1973


APPROVED AND SIGNED BY Arthur O. Enger MICHIGAN REGISTERED LAND SURVEYOR DATE December 28, 1973
 * (SEAL)

Michigan Department of Natural Resources
13581

SURVEYOR'S MICHIGAN REGISTRATION NO. _____


CORNER NUMBERING CODE DIAGRAMS FOR IDENTIFYING LAND CORNER RECORDATIONS AND INDEXING

**FOR PUBLIC LAND SURVEY CORNERS IN THE
T. 52N, R. 33W (MENTIONED OVER)**

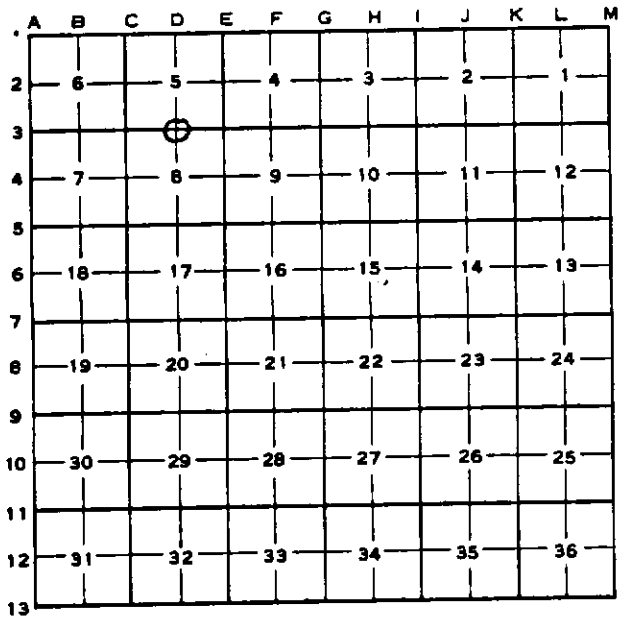

Apply letter prefix for corner points encircled above for identifying corner recordation numbers over.

FOR PROPERTY CONTROLLING AND MISC. PROPERTY CORNERS WITHIN THE SECTION (MENTIONED OVER AND EXCLUDE LOT CORNER)

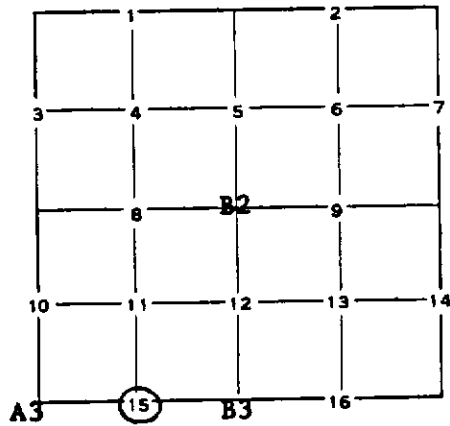

1. Above coded numbers are positioned on 1/16 fractional lines of the section.
2. Township corner code numbers shall be applied to corners of above typical section not numbered.
3. Miscellaneous property corners within a section, located at points other than numbered above, shall be referenced to at least two of above corner code numbers.
4. Private claim corners to be tied to rectangular land corners if possible - sketch required below.

EXPLANATORY SKETCH IF NECESSARY -- BELOW