

**SURVEY &  
REMONUMENTATION**

FEB 23 1998

**LAND CORNER RECORDATION CERTIFICATE**  
Filing Requirement of Act 74, Mich. P.A. 1970

For corners in **SECTION**

Baraga  
(County)

Located In:

Corner Code #

- |                                    |                           |       |
|------------------------------------|---------------------------|-------|
| 1. Public Land Survey              | T <u>52N</u> R <u>33W</u> | A-12* |
|                                    | T _____ R _____           | _____ |
|                                    | T _____ R _____           | _____ |
|                                    | T _____ R _____           | _____ |
| 2. Property Controlling in Section | S _____ T _____ R _____   | _____ |
|                                    | S _____ T _____ R _____   | _____ |
| 3. Miscellaneous Property in Sec.  | S _____ T _____ R _____   | _____ |
|                                    | S _____ T _____ R _____   | _____ |

RECEIVED FOR RECORD THIS 30TH DAY OF DECEMBER A.D. 1997 AT 10:30 A.M. AND RECORDED IN LIBER 4 OF LAND CORNER RECORDATION RECORDS ON PAGE 791-792

*Relda Bishop*  
BARAGA COUNTY REGISTER OF DEEDS

Register of Deeds Stamp & File Number

4. Lot No. \_\_\_\_\_, Recorded Plat \_\_\_\_\_  
5. Private Claims \_\_\_\_\_

I, Michael Mileski, in a field survey on 22 July, 19 97 do hereby state that under requirements of P.A. 74, Michigan P.A. of 1970, the corner points mentioned in lines 1 and 2 above were in conformance with regulations and rules therefore as required in the current manual of survey instructions of the United States Department of the Interior, Bureau of Land Management or by a decree of a Court of Law and for that the corner points mentioned in lines 3, 4 and 5 above were in conformance with the rules of the Michigan Board of Land Surveyors or by a Decree of a Court of Law; established, re-established, monumented, recovered, found as expressed below:

NOTE: Not more than 2 corners, all in the same town and range, may be recorded on this certificate.

A. Description of original monument and accessories and/or subsequent restoration:

A-12; West One-quarter Corner Section 31, T52N, R33W;

See back of form.

B. Description of corner evidence found and/or method applied in restoring or reestablishing corner:

A-12; West One-quarter Corner Section 31, T52N, R33W;

Found a 1" x 16" square iron rod flush with the surface of a north-south, 10-foot wide, woods road. An old fence runs west from this monument. Replaced found monument with a 1"(I.D.) x 36" galvanized iron pipe with cap. Accepted as the best available evidence of the position of the original corner.

C. Description of monument for corner and accessories established to perpetuate locating the position of the corner:

A-12; West One-quarter Corner Section 31, T52N, R33W;

Set a 1" (I.D.) x 36" galvanized iron pipe with cap stamped as to location 6" below the surface.

- |      |              |         |                                    |       |        |
|------|--------------|---------|------------------------------------|-------|--------|
| i)   | Set 7" spike | NW/side | 23" Maple                          | N47°E | 28.98' |
| ii)  | Set 7" spike | N/side  | 25" Maple                          | S55°E | 56.47' |
| iii) | Set 7" spike | NW/side | 7" Basswood                        | S63°W | 58.93' |
| iv)  | Set 7" spike | NE/side | 9" Yellow Birch                    | N51°W | 30.97' |
|      |              |         | 6" Steel fence post w/ yellow sign | East  | 10'    |

(i) and (ii) are Mr. Crampton's new bearing trees and are further described in Part A.


(iii) and (iv) are marked with upper and lower blazes. The lower blaze is scribed "NBT". Both blazes and a band around the tree at the upper blaze were painted red.

\*This corner is also M-12 of T52N, R34W.

	A	B	C	D	E	F	G	H	I	J	K	L	M
1													
2	6		5		4		3		2		1		
3													
4	7		8		9		10		11		12		
5													
6	18		17		16		15		14		13		
7													
8	19		20		21		22		23		24		
9													
10	30		29		28		27		26		25		
11													
12	31		32		33		34		35		36		
13													

APPROVED LAND CORNER  
P.A. 345 OF 1990  
Baraga County

10-31-97  
*[Signature]*

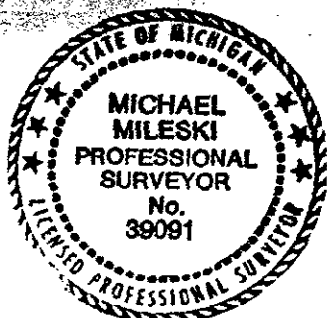

LIBER 4 PAGE 791

Signed by *[Signature]*  
Surveyor's Michigan License No. 39091

Date 19 Dec 1997

A. Description of original monument and accessories and/or subsequent restoration:

A-12; West One-quarter Corner Section 31, T52N, R33W;

Originally established during U.S. Survey conducted by William Burt, D.S. in 1845 and monumented with a wood post witnessed by a

Yellow Birch 20 N28°E 11 lks.

and a

Sugar 7 N70°W 30 lks.

This corner was recovered and perpetuated by William W. Stockly on 13 November 1907. Mr. Stockly observed that the yellow birch U.S. bearing tree is "growing" and that the sugar maple U.S. bearing tree is "obliterated". He remonumented the corner with an 8" cedar post and noted the following new bearing trees:

Sugar 8 East 41 lks.

and a

Sugar 8 West 32 lks.

This information is from Mr. Stockly's field book No. 15, pages 1556-1557, on file at the Michigan Technological University archives.

According to a Land Corner Recordation Certificate prepared by Robert Crampton, P.S. #24591 and recorded 20 December 1984 in Volume 2 on page 119 of the Houghton County Land Corner Records a "1 (in.) Square pin in centerline of an old road bed and on a projection of an old fence west of the corner" was recovered and accepted on 20 November 1984. Mr. Crampton did not remonument the corner. He noted the following new bearing trees:

26" Maple N47°E 27.80'

Presently alive and 23" in diameter.

I added an upper and lower blaze. The lower blaze was scribed "NBT". Both blazes and a band around the tree at the upper blaze were painted red.

Set 7" spike NW/side Measured N47°E 28.98'

30" Maple S56°E 55.84'

Presently alive and 25" in diameter. I added an upper and lower blaze. The lower blaze was scribed "NBT". Both blazes and a band around the tree at the upper blaze were painted red.

Set 7" spike N/side Measured S55°E 56.47'

5" Balsam S62°W 52.55'

Found standing dead (5" dia.).

Measured S62°W 52.57'

12" Balsam N35°W 34.5'

Found standing dead (7" dia.).

Measured N35°W 34.42'

Mr. Crampton had set his witness nail and tag on the face of both of his maple new bearing trees.

SURVEY &  
REMONUMENTATION

FEB 23 1998

SECTION