LAND CORNER RECORDATION CERTIFICATE
Filing Requirement of Act 74, Mich. P.A. 1970

For corners in

Baraga
(County)

RECEIVED FOR RECORD THIS 14TH DAY O
JANUARY A. D. 1999 AT 10:30 A. M. A
RECORDED IN LIBER 5 OF LAND CORNER
RECORDATION RECORDS ON PAGE 19.

Belda Bishop
BARAGA COUNTY REGISTER OF DEEDS

Register of Deeds Stamp & File Number

		Located In:	Corner Code #
1. Public Land Survey		T 52N R 33W	C-12
		T____ R____	
		T____ R____	
		T____ R____	
2. Property Controlling in Section	S____	T____ R____	
	S____	T____ R____	
3. Miscellaneous Property in Sec.	S____	T____ R____	
	S____	T____ R____	

4. Lot No. _____, Recorded Plat _____
5. Private Claims _____

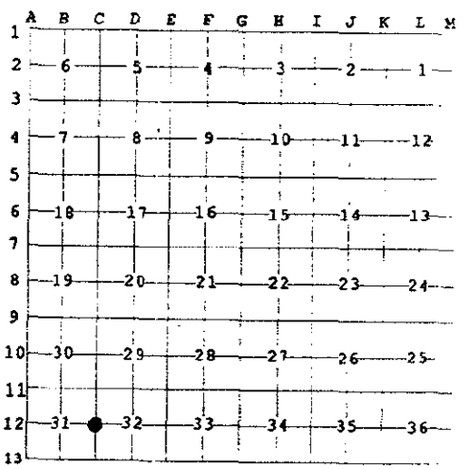

I, Michael Mileski, in a field survey on July, 19 98 do hereby state that under requirements of P.A. 74, Michigan P.A. of 1970, the corner points mentioned in lines 1 and 2 above were in conformance with regulations and rules therefore as required in the current manual of survey instructions of the United States Department of the Interior, Bureau of Land Management or by a decree of a Court of Law and /or that the corner points mentioned in lines 3, 4 and 5 above were in conformance with the rules of the Michigan Board of Land Surveyors or by a Decree of a Court of Law; established, re-established, monumented, recovered, found as expressed below:

NOTE: Not more than 2 corners, all in the same town and range, may be recorded on this certificate.

A. Description of original monument and accessories and/or subsequent restoration:

C-12; One-quarter Corner common to Sections 31 and 32, T52N, R33W;

Originally established during U.S. Survey conducted by William Burt, D.S. in 1849 and monumented with a hemlock post witnessed by a Hemlock 6 N26°E 11 lks. and a White Pine 14 S21°W 16 lks. This corner was remonumented with a 6" diameter cedar post by William Stockly on 12 November 1907 from the remains of both U.S. bearing trees. Mr. Stockly noted that the hemlock bearing tree was "nearly obliterated" and that the white pine bearing tree was found with the "stump standing". The following new bearing trees were recorded by Mr. Stockly: Fir 10 N75°W 36 lks. and a Yellow Birch 10 S68°W 55 lks.

B. Description of corner evidence found and/or method applied in restoring or reestablishing corner:

C-12; One-quarter Corner common to Sections 31 and 32, T52N, R33W;

Recovered the white pine U.S. bearing tree as an 18" diameter severely decayed stump having no marks. No evidence of Mr. Stockly's accessories was found. A cedar fence corner post with fence remains to the north and a mostly standing fence to the east bears N75°25'E a distance of 6.3 feet from this position. Accepted as the best available evidence of the position of the original corner.

C. Description of monument for corner and accessories established to perpetuate locating the position of the corner:

C-12; One-quarter Corner common to Sections 31 and 32, T52N, R33W;

Set a 1"(I.D.) x 36" galvanized iron pipe with cap stamped as to location projecting 6" above ground.

Set 7" spike	E/side	12" White Spruce	N04°E	46.27'
Set 7" spike	S/side	8" Balsam	N88°E	8.25'
Set 7" spike	SE/side	24" White Spruce	S66°W	36.85'
Set 7" spike	S/side	7" Cedar	N86°W	29.05'
		6' Steel fence post w/ yellow sign	North	1.0'

All of the above new bearing trees were marked with upper and lower blazes. The lower blaze was scribed "NBT". Both blazes and a band around the tree at the upper blaze were painted red.

STATE OF MICHIGAN
MICHAEL MILESKI
PROFESSIONAL SURVEYOR
No. 39091
LICENSED PROFESSIONAL SURVEYOR

APPROVED LAND CORNER
P.A. 345 OF 1990
Baraga County
12-10-98

Signed by _____ Date 28 Dec 1998

Surveyor's Michigan License No. 39091 LIBER 5 PAGE 19