

MAR 30 2000

SECTION

LAND CORNER RECORDATION CERTIFICATE
Filing Requirement of Act 74, Mich. P.A. 1970

For corners in

<u>Baraga</u> (County)	Located In:	Corner Code #
1. Public Land Survey	T <u>52N</u> R <u>33W</u>	<u>H-9</u>
	T _____ R _____	_____
	T _____ R _____	_____
	T _____ R _____	_____
2. Property Controlling in Section	S _____ T _____ R _____	_____
	S _____ T _____ R _____	_____
3. Miscellaneous Property in Sec.	S _____ T _____ R _____	_____
	S _____ T _____ R _____	_____

RECEIVED FOR RECORD THIS 25th DAY
FEBRUARY A.D. 2000 AT 10:30 A.M.
AND RECORDED IN LIBER 5 OF LAND
CORNER RECORDATION RECORDS ON
PAGE 83 and 84.

Nelda Bishop
BARAGA COUNTY REGISTER OF DEEDS
Register of Deeds Stamp & File Number

- 4. Lot No. _____, Recorded Plat _____
- 5. Private Claims _____

I, Michael Mileski, in a field survey on July, 19 99 do hereby state that under requirements of P.A. 74, Michigan P.A. of 1970, the corner points mentioned in lines 1 and 2 above were in conformance with regulations and rules therefore as required in the current manual of survey instructions of the United States Department of the Interior, Bureau of Land Management or by a decree of a Court of Law and /or that the corner points mentioned in lines 3, 4 and 5 above were in conformance with the rules of the Michigan Board of Land Surveyors or by a Decree of a Court of Law; established, re-established, monumented, recovered, found as expressed below:

NOTE: Not more than 2 corners, all in the same town and range, may be recorded on this certificate.

A. Description of original monument and accessories and/or subsequent restoration:

H-9; One-quarter Corner common to Sections 22 and 27, T52N, R33W;

See back of form.

B. Description of corner evidence found and/or method applied in restoring or reestablishing corner:

H-9; One-quarter Corner common to Sections 22 and 27, T52N, R33W;

No monument was found at this corner. Reestablished the corner on line between the NW corner of section 27 and the NW corner of Lot 1 of the plat of Bayshore Acres at the 1935 Michigan State Highway Department distance of 2631.5 feet from the NW corner of section 27. This position is 632.2 feet east of the physical centerline of old U.S. Highway 41 (recorded as 637.4' - MSHD 1935). The center 1/4 corner of section 22 as recorded by Robert Crampton, PS #24591 on 13 May 1987 in Liber 4, page 162 lies 2.46 feet west of a line connecting this position for the corner with the north 1/4 corner of section 27. This position falls 0.8 feet north of the physical centerline of an east-west, 20-foot wide, asphalt road.

C. Description of monument for corner and accessories established to perpetuate locating the position of the corner:

H-9; One-quarter Corner common to Sections 22 and 27, T52N, R33W;

Set a 1" (I.D.) x 30" galvanized iron pipe with cap. This monument was set 12 inches below the asphalt. The 8 inch diameter asphalt opening was filled with 6 inches of MDOT-furnished CP-7 material. A 7" spike was set at the surface directly above the iron pipe monument.

Set 7" spike	W/side	16" Black Ash	N03°W	35.97'
Set 7" spike	W/side	17" Black Ash	S02°W	56.17'
Set 7" spike	SE/side	14" Balsam	S37°W	50.81'
		6' Steel fence post w/ yellow sign	North	22.0'

All of the above new bearing trees were marked with upper and lower blazes. The lower blaze was scribed "NBT". Both blazes and a band around the tree at the upper blaze were painted red.


APPROVED LAND CORNER
P.A. 345 OF 1990
Baraga County

Signed by *Michael Mileski*

Surveyor's Michigan License No. 39091

12-16-99
[Signature]

Date 27 Dec 1999

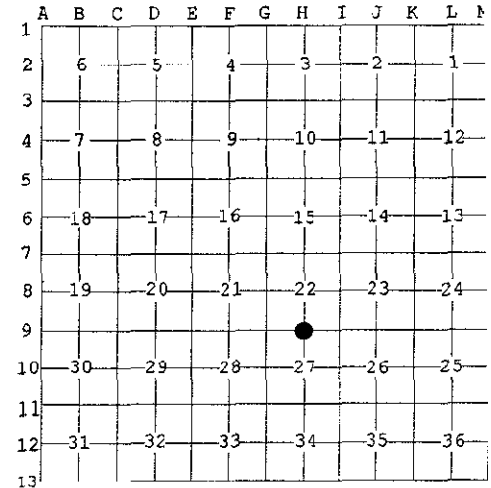

MAR 30 2000

SECTION

A. Description of original monument and accessories and/or subsequent restoration:

H-9; One-quarter Corner common to Sections 22 and 27, T52N, R33W;

Originally established during U.S. Survey conducted by William Burt, D.S. in 1849 and monumented with a cedar post witnessed by a

Cedar 6 N27°W 25 lks.

and a

Black Ash 8 S23°W 32 lks.

On the Michigan State Highway Department plans for the U.S. Works Program Grade Crossing Project No. W.P.G.H. 3 Sec. E (File no. R-28-A-2A) approved 7 November 1935, this corner is indicated as being 2631.5 feet east of the NW corner of section 27. No description of the monument or accessories is noted. The corner is also indicated as being 637.4 feet east of the centerline of U.S. Highway 41.

The plat of "Bayshore Acres" recorded on 18 August 1967 in Volume 3 of Plats, page 77, Baraga County Records does not indicate this corner. Rather, the plat which is bounded on the north by the section line only indicates the NW corner of section 27 and the meander corner common to sections 22 and 27. The plat of Bayshore Acres was surveyed by Helmuth Steinhilb, PS #8896.

This corner is not indicated or discussed on the Michigan State Highway Department plans for State Projects F07013-004 and Ms07012-006 approved 8 February 1968.