

LAND CORNER RECORDATION CERTIFICATE
Filing Requirement of Act 74, Mich. P.A. 1970 as Amended

For corners in

<u>Baraga</u> (County)	Located In:	Corner Code #
1. Public Land Survey	T _____ R _____	_____
	T _____ R _____	_____
	T _____ R _____	_____
2. Property Controlling in Section	S <u>3</u> T <u>52N</u> R <u>33W</u>	<u>1</u>
	S <u>3</u> T <u>52N</u> R <u>33W</u>	<u>8</u>
3. Miscellaneous Property in Sec.	S _____ T _____ R _____	_____
	S _____ T _____ R _____	_____
4. Lot No. _____, Recorded Plat _____		
5. Private Claims		

Register of Deeds Stamp & File
Number

	A	B	C	D	E	F	G	H	I	J	K	L	M
1													
2	6		5		4		3		2		1		
3													
4	7		8		9		10		11		12		
5													
6	18		17		16		15		14		13		
7													
8	19		20		21		22		23		24		
9													
10	30		29		28		27		26		25		
11													
12	31		32		33		34		35		36		
13													

I, Stephan J. Szyszkoski, in a field survey on Apr 18, 2007 do hereby state that under requirements of P.A. 74, Michigan P.A. of 1970, the corner points mentioned in lines 1 and 2 above were in conformance with regulations and rules therefore as required in the current manual of survey instructions of the United States Department of the Interior, Bureau of Land Management or by a decree of a Court of Law and /or that the corner points mentioned in lines 3, 4 and 5 above were in conformance with the rules of the Michigan Board of Land Surveyors or by a Decree of a Court of Law; established, re-established, monumented, recovered, found as expressed below:


NOTE: Not more than 2 corners, all in the same town and range, may be recorded on this certificate.

- A. Description of original monument and accessories and/or subsequent restoration:
 (1-Sec. 3) West 1/16 corner between Sec. 3 T52N-R33W and Section 34 T53N-R33W. Not established in the original survey.
 (8-Sec. 3) West 1/16 corner, Section 3. Not established in the original survey.

- B. Description of corner evidence found and/or method applied in restoring or reestablishing corner:
 (1-Sec. 3) Established the corner midway and on the Township line between between Section corner 1331.83' West and Quarter corner 1331.83' East.
 (8-Sec. 3) Established the corner midway and on a straight line between Quarter corner 1317.72' west and Center of Section 3 1317.72' east.

- C. Description of monument for corner and accessories established to perpetuate locating the position of the corner:
 (1) Set 1"IDx32" I.pipe with 4" alum. MDNR cap. Set measuring nail with MDNR tag in the side of:
 16" Hemlock S20E 9.8' mrkd "1/16S BT"
 9" Cedar S22W 20.8' do
 11" Hemlock S84W 12.9' do
 13" Cedar N48W 8.4' do
 Set sq'd cedar post adjacent. Bearings are magnetic.
 (8) Set 1"IDx32" I.pipe with 4" alum. MDNR cap. Set measuring nail with MDNR tag in the side of:
 10" Sugar N72E 26.5' mrkd "1/16S BT"
 10" Cedar S08E 29.6' do
 9" Cedar S33W 24.3' do
 6" Sugar N30W 39.9' do
 Set sq'd cedar post adjacent. Bearings are magnetic.

Signed by Steph J. Szyszkoski

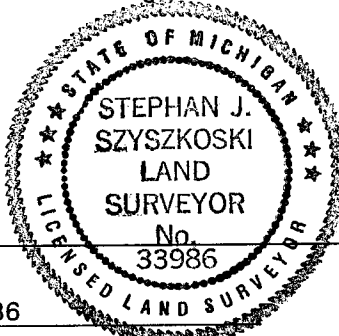

Date 11/27/07

Surveyor's Michigan License No. 33986