LAND CORNER RECORDATION CERTIFICATE

Filing Requirement of Act 74, Mich. P.A. 1970 as Amended

For corners in

Baraga (County) Located In: Corner Code #

1. Public Land Survey		T 52N	R 33W	E8
		T	R	
		T	R	
2. Property Controlling in Section	S	T	R	
	S	T	R	
	S	T	R	
3. Miscellaneous Property in Sec.	S	T	R	
	S	T	R	

4. Lot No. _____, Recorded Plat _____

5. Private Claims

Register of Deeds Stamp & File Number

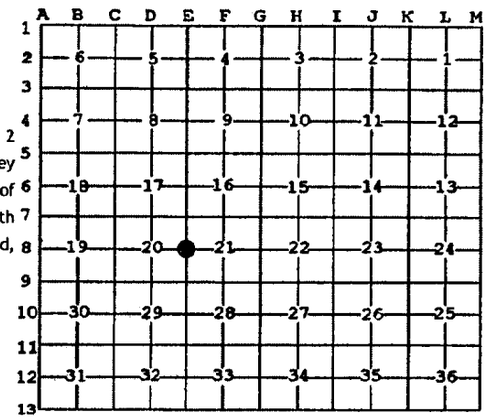

I, Stephan J. Szyszkoski, in a field survey on 09/27/2007 do hereby state that under requirements of P.A. 74, Michigan P.A. of 1970, the corner points mentioned in lines 1 and 2 above were in conformance with regulations and rules therefore as required in the current manual of survey instructions of the United States Department of the Interior, Bureau of Land Management or by a decree of a Court of Law and /or that the corner points mentioned in lines 3, 4 and 5 above were in conformance with the rules of the Michigan Board of Land Surveyors or by a Decree of a Court of Law; established, re-established, monumented, recovered, found as expressed below:

NOTE: Not more than 2 corners, all in the same town and range, may be recorded on this certificate.

A. Description of original monument and accessories and/or subsequent restoration:

(E8) Quarter corner common to Sections 20 and 21. 1849 - Established by Wm.A.Burt Deputy Surveyor midway and on line between Section corners 40.00 chains north and south. Set Tamarack post. Tamarack 6" N44E 13 links, Tamarack 4 S61W 36 links. 1907 - Recovered by Wm.W.Stockly, engineer during his subdivision of Section 21. No new witnesses of record.

B. Description of corner evidence found and/or method applied in restoring or reestablishing corner:

(E8) Recovered the point of the original Tamarack corner post, rotted off at the level of the water table, sound below, at record bearing and distance from the stump remains of the BT Tamarack S61W 36 links, with open faces and scribing visible. The BT NE was not recovered. Found a second post point adjacent to the original post point, smaller, which had been driven in at an angle, and which probably served as a backsight during the 1907 Stockly survey. Replaced the point of the original Tamarack post with a monument as described below. Assistance in monumentation was provided by Patrick Leemon RLS and members of the Michigan Technological University's Douglas Houghton Student Chapter of the Michigan Society of Professional Surveyors. The remains of the Tamarack BT and the original post are in the possession of said Chapter.

C. Description of monument for corner and accessories established to perpetuate locating the position of the corner:

(E8) Set 1"IDx48" I.pipe with 4" alum. MDNR cap.
Set measuring nail with MDNR tag in the side of:
7" Tamarack S68W 8.90' mrkd "1/4S NBT"
8" Tamarack N27W 21.99' do
9" Tamarack N31E 25.75' do
7" Tamarack S54E 9.39' do
Placed sq'd post adjacent. Bearings magnetic.

STATE OF MICHIGAN
STEPHAN J. SZYSZKOSKI
LAND SURVEYOR
No. 33986
LICENSED LAND SURVEYOR

Signed by Stephan J. Szyszkoski Date 09/04/2008

Surveyor's Michigan License No. 33986

For the Michigan Department of Natural Resources, Office of Land and Facilities

FORM APPROVED BY MICHIGAN STATE BOARD OF PROFESSIONAL SURVEYORS, JAN. 28, 1971
Revised May 14, 1975
Revised Jan., 1983
Revised Oct., 1995

16132