

SURVEY & REMONUMENTATION

NOV 04 1996

For corners in **COMMISSION**

BARRY

(County)

BARRY COUNTY REMONUMENTATION

LAND CORNER RECORDATION CERTIFICATE
Filing Requirement of Act 74, Mich. P.A. 1970

STATE OF MICHIGAN
COUNTY OF BARRY
RECEIVED FOR RECORD

AUG 20 11 27 AM '96

Sandy Schondelmayer

REGISTER OF DEEDS

002381

Register of Deeds Stamp & File Number

- | | | | | | |
|--|---|-----------|---|------------|-------|
| 1. Public Land Survey | T | <u>1N</u> | R | <u>R7W</u> | C-5 |
| CORNER COMMON TO SECTIONS 7, 8, 17, & 18 ASSYRIA TOWNSHIP | T | _____ | R | _____ | _____ |
| 2. Property Controlling in Section | S | _____ | T | _____ | _____ |
| 3. Miscellaneous Property in Sec. | S | _____ | T | _____ | _____ |
4. Lot No. _____, Recorded Plat _____
5. Private Claims _____

A	B	C	D	E	F	G	H	I	J	K	L	M
2	6	5	4	3	2	1						
3												
4	7	8	9	10	11	12						
5		●										
6	18	17	16	15	14	13						
7												
8	19	20	21	22	23	24						
9												
10	30	29	28	27	26	25						
11												
12	31	32	33	34	35	36						
13												

I, **BRIAN REYNOLDS**, in a field survey on **22 FEBRUARY**, 19**95**, do hereby certify that under requirements of P.A. 74, Michigan P.A. of 1970, the corner points mentioned in lines 1 and 2 above were in conformance with regulations and rules therefore as required in the current manual of survey instructions of the United States Department of the Interior, Bureau of Land Management or by a decree of a Court of Law and/or that the corner points mentioned in lines 3, 4 and 5 above were in conformance with the rules of the Michigan Board of Land Surveyors or by a Decree of a Court of Law; established, re-established, monumented, re-monumented, recovered, found as expressed below:

NOTE: Not more than 4 corners, all in the same town and range, may be recorded on this certificate.

A. Description of original monument and accessories and/or subsequent restoration

GENERAL LAND OFFICE: MUSGROVE EVANS, D.S., 1826 (R7W,P.37)
B. ASH 12 N66E 82 W. OAK 12 N55W 63 links

COUNTY SURVEYOR RECORDS: PRATT APRIL 29, 1890(ASSYRIA F.B., P.3)
"TAMRAC STAKE" ELM 20 S84°1/2W 39

PRIVATE NOTES OF SURVEY BY DAN RYAN, P.S. #34975, c. 1991, NAIL IN GRAVEL ROAD, NOT WITNESSED
ORAL TESTIMONY OF KENNETH BRANDT, P.S. #24587, NAIL USED FOR BREAKDOWN OF SECTION 7


NO OTHER RECORDED HISTORICAL INFORMATION AVAILABLE FOR THIS CORNER

B. Description of corner evidence found and/or method applied in restoring or reestablishing corner:

SEARCHED FOR CORNER MONUMENT AT LOCATION INDICATED BY OCCUPATION, FOUND NAIL IN GRAVEL BASED ON TIES TO OCCUPATION LINES IN SECTIONS 17 & 18 ACCEPTED FOUND NAIL AS BEST EVIDENCE OF CORNER LOCATION. REPLACED FOUND NAIL WITH STANDARD BARRY COUNTY REMONUMENTATION MONUMENT AT THE INTERSECTION OF OCCUPATION BETWEEN SECTIONS 7 & 18 AS DEFINED BY CENTERLINE OF GRAVEL ROAD AND OCCUPATION FENCE NORTH BETWEEN SECTIONS 7 & 8 AND FENCE OCCUPATION SOUTH BETWEEN SECTIONS 17 AND 18.

ACT 345 BARRY COUNTY REMONUMENTATION
APPROVED BY PEER REVIEW AT A MEETING HELD ON

B. Reynolds
BRIAN REYNOLDS COUNTY SURVEYOR

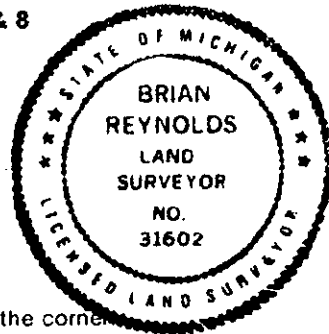

C. Description of monument for corner and accessories established to perpetuate locating the position of the corner:

SET STANDARD BARRY COUNTY REMONUMENTATION MONUMENT (3/4"X36"W/ALUMINUM CAP)
SET 40d NAIL W/PLASTIC TAG IN THE NORTHEAST SIDE OF A 10"ELM N47°W 30.93'
SET 40d NAIL W/PLASTIC TAG IN THE SOUTHEAST SIDE OF A 9" MAPLE N70°E 54.90'
SET 40d NAIL W/PLASTIC TAG IN THE NORTH SIDE BASE OF A 10" TWIN OAK N88°W 254.23'
SET 40d NAIL W/PLASTIC TAG IN THE SOUTH SIDE EAST TRUNK 10"TRIPLE OAK S88°W 375.22'
SET 40d NAIL W/PLASTIC TAG IN THE TOP CENTER OF A WOODEN FENCE POST SOUTH 35.16'
CORNER LIES ROUGHLY ON THE CENTERLINE OF EAST-WEST GRAVEL ROAD
IN LINE WITH FENCE SOUTH AND DECAYED FENCE NORTH

Signed by *Brian Reynolds* Date AUGUST 16, 1996
Surveyor's Michigan License No. 31602