

SURVEY & REMONUMENTATION

NOV 4 1996

COMMISSION

BARRY COUNTY REMONUMENTATION

LAND CORNER RECORDATION CERTIFICATE
Filing Requirement of Act 74, Mich. P.A. 1970

STATE OF MICHIGAN
COUNTY OF BARRY
RECEIVED FILE RECORD

AUG 20 11 27 AM '96

Sandy Schondelmar

REGISTER OF DEEDS

002380

Register of Deeds Stamp & File Number

For corners in

BARRY

(County)

Located In:

Corner Code #

1. Public Land Survey
CENTER OF SECTION 17
ASSYRIA TOWNSHIP

T 1N R 7W

D-6

T _____ R _____

T _____ R _____

T _____ R _____

2. Property Controlling
in Section

S _____ T _____ R _____

S _____ T _____ R _____

3. Miscellaneous
Property in Sec.

S _____ T _____ R _____

S _____ T _____ R _____

4. Lot No. _____, Recorded Plat _____

5. Private Claims _____

BRIAN REYNOLDS

22 FEBRUARY

95

I, BRIAN REYNOLDS, in a field survey on 22 FEBRUARY, 1995, do hereby certify that under requirements of P.A. 74, Michigan P.A. of 1970, the corner points mentioned in lines 1 and 2 above were in conformance with regulations and rules therefore as required in the current manual of survey instructions of the United States Department of the Interior, Bureau of Land Management or by a decree of a Court of Law and/or that the corner points mentioned in lines 3, 4 and 5 above were in conformance with the rules of the Michigan Board of Land Surveyors or by a Decree of a Court of Law; established, re-established, monumented, re-monumented, recovered, found as expressed below:

NOTE: Not more than 4 corners, all in the same town and range, may be recorded on this certificate.

A. Description of original monument and accessories and/or subsequent restoration.

CORNER NOT SET BY GENERAL LAND OFFICE.

NO RECORDED HISTORICAL INFORMATION AVAILABLE FOR THIS CORNER


	A	B	C	D	E	F	G	H	I	J	K	L	M
2	6		5		4		3		2		1		
3													
4	7		8		9		10		11		12		
5													
6	18				16		15		14		13		
7													
8	19		20		21		22		23		24		
9													
10	30		29		28		27		26		25		
11													
12	31		32		33		34		35		36		
13													

B. Description of corner evidence found and/or method applied in restoring or reestablishing corner:

**EXTENSIVE EXCAVATION AT INTERSECTION OF GRAVEL ROADS REVEALED NOTHING.
SET STANDARD BARRY COUNTY REMONUMENTATION MONUMENT AT INTERSECTION OF 1/4 LINES,
DEFINED BY RESTORED 1/4 CORNERS.**

ACT 345 BARRY COUNTY REMONUMENTATION
APPROVED BY PEER REVIEW AT A MEETING HELD ON

13 March '95
BRIAN REYNOLDS
COUNTY SURVEYOR

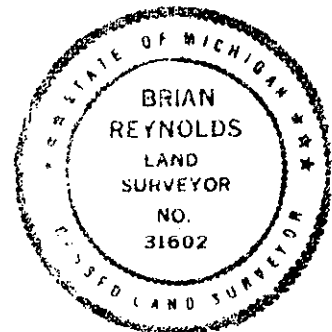

C. Description of monument for corner and accessories established to perpetuate locating the position of the corner:

**SET STANDARD BARRY COUNTY REMONUMENTATION MONUMENT (3/4"X36"W/ALUMINUM CAP)
SET 40d NAIL W/PLASTIC TAG IN THE SOUTH BASE OF A 30" OAK N60°W 29.90'
SET 40d NAIL W/PLASTIC TAG IN THE EAST SIDE EAST TRUNK OF A 9" TWIN MAPLE N12°W 32.35'
SET 40d NAIL W/PLASTIC TAG IN THE SOUTHWEST SIDE OF A 12" MAPLE S52°E 76.10'
SET 40d NAIL W/PLASTIC TAG IN THE NORTHWEST SIDE OF A 20" OAK S40°W 15.49'
SET 40d NAIL W/PLASTIC TAG IN THE SOUTH SIDE OF A 22" OAK S84°W 47.92'
CORNER LIES 13'+/- WEST OF THE CENTERLINE OF A NORTH-SOUTH GRAVEL ROAD
7'+/- SOUTH OF A GRAVEL ROAD EAST
ROUGHLY ON CENTERLINE OF AN OLD ABANDONED ROAD LEADING WEST TO THE SHORE OF A LAKE**

[Handwritten signature]

Signed by _____
Surveyor's Michigan License No. 31602

Date AUG 16, 1996