

SURVEY & REMONUMENTATION

AUG 22 1995

COMMISSION

BARRY COUNTY REMONUMENTATION

LAND CORNER RECORDATION CERTIFICATE
Filing Requirement of Act 74, Mich. P.A. 1970

STATE OF MICHIGAN
COUNTY OF BARRY
RECEIVED FOR RECORD

MAR 20 10 55 AM '95

Sandy Schondelmayer
REGISTER OF DEEDS

For corners in **BARRY**
(County)

Located In: Corner Code #

1. Public Land Survey 1/4 CORNER COMMON TO SECTIONS 17 & 20 ASSYRIA TOWNSHIP	T <u>1N</u> R <u>7W</u>	<u>D-7</u>
	T _____ R _____	_____
	T _____ R _____	_____
	T _____ R _____	_____
2. Property Controlling in Section	S _____ T _____ R _____	_____
	S _____ T _____ R _____	_____
3. Miscellaneous Property in Sec.	S _____ T _____ R _____	_____
	S _____ T _____ R _____	_____

002284

Register of Deeds Stamp & File Number

4. Lot No. _____, Recorded Plat _____
5. Private Claims _____

	A	B	C	D	E	F	G	H	I	J	K	L	M
2	6	5	4	3	2	1							
3													
4	7	8	9	10	11	12							
5													
6	18	17	16	15	14	13							
7													
8	19	20	21	22	23	24							
9													
10	30	29	28	27	26	25							
11													
12	31	32	33	34	35	36							
13													

I, **BRIAN REYNOLDS**, in a field survey on **22 FEBRUARY**, 19**95**, do hereby certify that under requirements of P.A. 74, Michigan P.A. of 1970, the corner points mentioned in lines 1 and 2 above were in conformance with regulations and rules therefore as required in the current manual of survey instructions of the United States Department of the Interior, Bureau of Land Management or by a decree of a Court of Law and/or that the corner points mentioned in lines 3, 4 and 5 above were in conformance with the rules of the Michigan Board of Land Surveyors or by a Decree of a Court of Law; established, re-established, monumented, re-monumented, recovered, found as expressed below:

NOTE: Not more than 4 corners, all in the same town and range, may be recorded on this certificate.

A. Description of original monument and accessories and/or subsequent restoration:

GENERAL LAND OFFICE: MUSGROVE EVANS, D.S., 1826 (R7W,P.36) "WEST CORRECTED 40.09"
ASPEN 14 N.22E. 3 lks W. OAK 5 S.18W. 27 lks

NO OTHER RECORDED HISTORICAL INFORMATION AVAILABLE FOR THIS CORNER
PRIVATE NOTES OF DAN RYAN, P.S. #34975 (OF KING, RYAN & ASSOC.) c.1990 PROVIDED BY WILLIAM CRANE, INDICATE FOUND CONCRETE MONUMENT WEST OF NORTH-SOUTH GRAVEL ROAD, USED FOR CORNER, BUT NOT RECORDED OR WITNESSED


B. Description of corner evidence found and/or method applied in restoring or reestablishing corner:

FOUND CONCRETE MONUMENT AS INDICATED IN NOTES BY DAN RYAN. MEASUREMENTS TO OTHER CORNERS AND OCCUPATION LINES PROVED INCONSISTENT WITH MONUMENT LOCATION. EXCAVATED BELOW GRAVEL ROAD SURFACE AND FOUND BENT 3/4" IRON, 3' BELOW ROAD SURFACE, IN LINE WITH TREE LINE AND FENCE RUNNING WEST.
ACCEPTED FOUND IRON AS CORNER, DISREGARDED CONCRETE MONUMENT.
SET STANDARD BARRY COUNTY REMONUMENTATION MONUMENT AT POSITION OF FOUND IRON.

ACT 345 BARRY COUNTY REMONUMENTATION
APPROVED BY PEER REVIEW AT A MEETING HELD ON

6 Dec. '94
BRIAN REYNOLDS

COUNTY SURVEYOR

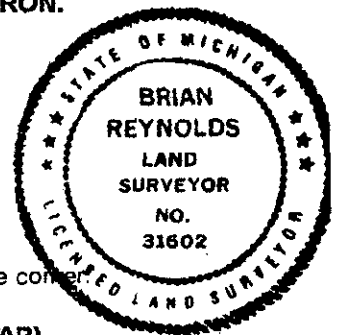

C. Description of monument for corner and accessories established to perpetuate locating the position of the corner:

SET STANDARD BARRY COUNTY REMONUMENTATION MONUMENT (3/4"X36"W/ALUMINUM CAP)
SET 40d NAIL W/PLASTIC TAG IN THE NORTH SIDE OF AN 8" CHERRY S71°W 40.94'
SET 40d NAIL W/PLASTIC TAG IN THE WEST SIDE OF A 16' OAK S46°W 43.53'
SET 40d NAIL W/PLASTIC TAG IN THE WEST SIDE OF A 14" CHERRY N19°E 62.66'
SET 40d NAIL W/PLASTIC TAG IN THE NORTHEAST SIDE OF A 4" MULTIPLE CHERRY S53°E 31.92'
1/2" IRON IN A CONCRETE MONUMENT N88°W 27.01'
CORNER LIES 4' +/- EAST OF THE CENTERLINE OF A GRAVEL ROAD NORTH-SOUTH

Signed by _____ Date _____

Surveyor's Michigan License No. _____