

SURVEY & REMONUMENTATION

FEB 17 1998

BARRY COUNTY REMONUMENTATION LAND CORNER RECORDATION CERTIFICATE Filing Requirement of Act 74, Mich. P.A. 1970

For corners in SECTION

BARRY
(County)

Located In:

Corner



2644
Page: 1 of 1
12/16/1997 12:20P

Sandy Schondelmayer - Barry Co. LCRCR

ASSYRIA TOWNSHIP
1. Public Land Survey T 1N R 7W D-13
T _____ R _____
T _____ R _____
T _____ R _____
2. Property Controlling S _____ T _____ R _____
in Section S _____ T _____ R _____
3. Miscellaneous S _____ T _____ R _____
Property in Sec. S _____ T _____ R _____

Register of Deeds Stamp & File Number

4. Lot No. _____, Recorded Plat _____
5. Private Claims _____

I, ROBERT R. CARR, in a field survey on APRIL 5, 19 97 do hereby state that under requirements of P.A. 74, Michigan P.A. of 1970, the corner points mentioned in lines 1 and 2 above were in conformance with regulations and rules therefore as required in the current manual of survey instructions of the United States Department of the Interior, Bureau of Land Management or by a decree of a Court of Law and /or that the corner points mentioned in lines 3, 4 and 5 above were in conformance with the rules of the Michigan Board of Land Surveyors or by a Decree of a Court of Law; established, re-established, monumented, recovered, found as expressed below:

NOTE: Not more than 2 corners, all in the same town and range, may be recorded on this certificate.

| | A | B | C | D | E | F | G | H | I | J | K | L | M |
|----|---|----|---|----|---|----|---|----|---|----|---|----|---|
| 1 | | | | | | | | | | | | | |
| 2 | | 6 | | 5 | | 4 | | 3 | | 2 | | 1 | |
| 3 | | | | | | | | | | | | | |
| 4 | | 7 | | 8 | | 9 | | 10 | | 11 | | 12 | |
| 5 | | | | | | | | | | | | | |
| 6 | | 18 | | 17 | | 16 | | 15 | | 14 | | 13 | |
| 7 | | | | | | | | | | | | | |
| 8 | | 19 | | 20 | | 21 | | 22 | | 23 | | 24 | |
| 9 | | | | | | | | | | | | | |
| 10 | | 30 | | 29 | | 28 | | 27 | | 26 | | 25 | |
| 11 | | | | | | | | | | | | | |
| 12 | | 31 | | 32 | | 33 | | 34 | | 35 | | 36 | |
| 13 | | | | | | | | | | | | | |

A. Description of original monument and accessories and/or subsequent restoration:

G.L.O. JOHN MULLET D.S. 1825; W. OAK 10 N5°W 11; DO 8 N60°E 26.
McPHERSON 1965, CONSUMER POWER COMPANY RESET WITH 5/8" IRON
UTILITY POLE, S85°E 19.45 FEET; 6" HICKORY, N78°W 26.58 FEET; 5.3 FEET NORTH OF EAST
AND WEST FENCE
JAMES L. KING R.L.S. NO. 14766 DEKEYSER AND ASSOCIATES 1976 UNRECORDED SURVEY
5/8" IRON; 3" MAPLE N5°E 34.6 FEET; UTILITY POLE, S85°E 19.45 FEET.


B. Description of corner evidence found and/or method applied in restoring or reestablishing corner:

5/8" IRON GONE DUE TO EROSION OF BANK.
REESTABLISHED LOCATION FROM UNRECORDED SURVEY BY JAMES L. KING AND DISTANCE (795.28 FEET) EAST OF NORTHWEST CORNER OF SECTION 5, TOWN 1 SOUTH, RANGE 7 WEST PER CONSUMERS POWER SURVEY 1965.

ACT 345 BARRY COUNTY REMONUMENTATION
APPROVED BY PEER REVIEW AT A MEETING HELD ON
8 SEPT, 97
BRIAN REYNOLDS COUNTY SURVEYOR

C. Description of monument for corner and accessories established to perpetuate locating the position of the corner:

BARRY COUNTY REMONUMENTATION CAP ON 3/4" BAR 8' ± LONG IN FACE OF
STEEP BANK ON SOUTH SIDE OF DRIVEWAY.
UTILITY POLE, S60°E 20.25 FEET, SET SPOTTER
20" MAPLE, N22°E 30.65 FEET, SET SPOTTER
8" OAK, S17°E 6.93 FEET, SET SPOTTER
10" CHERRY, S87°E 30.19 FEET, SET SPOTTER
3" OAK, S44°W 20.53 FEET, SET SPOTTER.

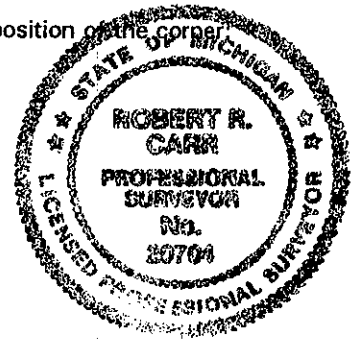

Signed by [Signature]
Surveyor's Michigan License No. 20704

Date NOV. 7, 1997