

SURVEY & REMONUMENTATION

BARRY COUNTY REMONUMENTATION

STATE OF MICHIGAN  
COUNTY OF BARRY  
RECEIVED FOR RECORD

OCT 27 1994

LAND CORNER RECORDATION CERTIFICATE  
Filing Requirement of Act 74, Mich. P.A. 1970

OCT 7 2 04 PM '94

For corners in  
BARRY

COMMISSION

Sandy Schondelmayr  
REGISTER OF DEEDS

(County)	Located In:	Corner Code #
1. Public Land Survey	T <u>1N</u> R <u>7W</u>	<u>E-7</u>
<b>CORNER COMMON TO SECTIONS 16,17,20, AND 21 ASSYRIA TOWNSHIP</b>	T _____ R _____	_____
2. Property Controlling in Section	S _____ T _____ R _____	_____
3. Miscellaneous Property in Sec.	S _____ T _____ R _____	_____

002232

Register of Deeds Stamp & File Number

- 4. Lot No. \_\_\_\_\_, Recorded Plat \_\_\_\_\_
- 5. Private Claims \_\_\_\_\_

	A	B	C	D	E	F	G	H	I	J	K	L	M
2	6	5	4	3	2	1							
3													
4	7	8	9	10	11	12							
5													
6	13	17	16	15	14	13							
7													
8	19	20	21	22	23	24							
9													
10	30	29	28	27	26	25							
11													
12	31	32	33	34	35	36							
13													


I, **BRIAN REYNOLDS**, in a field survey on **12 SEPTEMBER**, 19**1994**, do hereby certify that under requirements of P.A. 74, Michigan P.A. of 1970, the corner points mentioned in lines 1 and 2 above were in conformance with regulations and rules therefore as required in the current manual of survey instructions of the United States Department of the Interior, Bureau of Land Management or by a decree of a Court of Law and/or that the corner points mentioned in lines 3, 4 and 5 above were in conformance with the rules of the Michigan Board of Land Surveyors or by a Decree of a Court of Law; established, re-established, monumented, re-monumented, recovered, found as expressed below:

**NOTE: Not more than 4 corners, all in the same town and range, may be recorded on this certificate.**

- A. Description of original monument and accessories and/or subsequent restoration:
- GENERAL LAND OFFICE: MUSGROVE EVANS, D.S. 1826, (R7W,P.31) A W.O. 16 N56E 25 Do. 16 S7W 19**
  - NO OTHER RECORDED HISTORICAL INFORMATION COULD BE FOUND FOR THIS CORNER**

B. Description of corner evidence found and/or method applied in restoring or reestablishing corner:  
**FOUND FENCE CORNER POST WITH FENCES RUNNING EAST, NORTH, AND SOUTH, WITH DECAYED FENCE RUNNING WEST. EXCAVATED AROUND CORNER POST 3'+/- DEEP, FOUND SMALL TO MEDIUM SIZED STONES ALONG WITH CROCKERY ENCIRCLING THE POST, MORE CROCKERY FOUND ON WEST SIDE OF POST THAN OTHER SIDES. ACCEPTED FOUND CROCKERY AND STONES TO BE BEST EVIDENCE OF CORNER POSITION. SET STANDARD BARRY COUNTY REMONUMENTATION IRON ON WEST SIDE OF CORNER FENCE POST**

ACT 345 BARRY COUNTY REMONUMENTATION  
 APPROVED BY PEER REVIEW AT A MEETING HELD ON  
4 Oct. '94  
**BRIAN REYNOLDS** COUNTY SURVEYOR

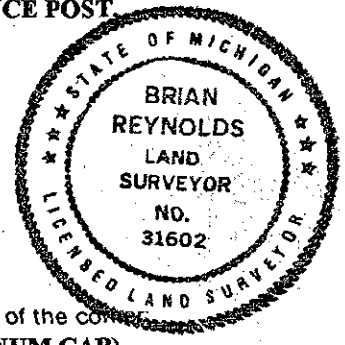

- C. Description of monument for corner and accessories established to perpetuate locating the position of the corner:
- SET STANDARD BARRY COUNTY REMONUMENTATION MONUMENT (3/4"X36"W/ALUMINUM CAP)**
  - SET 40d NAIL W/REMON TAG IN THE NORTH SIDE OF A 12" MAPLE N85W 23.80'**
  - SET 40d NAIL W/REMON TAG IN THE NORTH SIDE OF A 12" OAK S80W 24.43'**
  - SET 40d NAIL W/REMON TAG IN THE WEST SIDE OF A 14" OAK S5E 42.28'**
  - SET 40d NAIL W/REMON TAG IN THE NORTH SIDE OF AN 18" OAK S25W 45.29'**
  - CORNER LIES 0.2' WEST OF A FENCE CORNER POST WITH FENCE RUNNING NORTH, SOUTH, AND EAST IN LINE WITH FENCE EAST AND IN LINE WITH TREE LINE RUNNING WEST**

Signed by *Brian Reynolds* Date OCT 7, 1994  
 Surveyor's Michigan License No. 31602