

DEC 7 4 26 PM '93

Sandy Schondelmar
REGISTER OF DEEDS

BARRY COUNTY REMONUMENTATION
LAND CORNER RECORDATION CERTIFICATE
Filing Requirement of Act 74, Mich. P.A. 1970

002128

Register of Deeds Stamp & File Number

For corners in
Calhoun
(County)

Located In: Corner Code ##

- | | | |
|---------------------------------------|-------------------------|------------|
| 1. Public Land Survey | T <u>1N</u> R <u>7W</u> | <u>G-6</u> |
| | T _____ R _____ | _____ |
| | T _____ R _____ | _____ |
| | T _____ R _____ | _____ |
| 2. Property Controlling in Section | S _____ T _____ R _____ | _____ |
| | S _____ T _____ R _____ | _____ |
| 3. Miscellaneous Property in Sec. | S _____ T _____ R _____ | _____ |
| | S _____ T _____ R _____ | _____ |
| 4. Lot No. _____, Recorded Plat _____ | | |
| 5. Private Claims _____ | | |

I, Daniel M. Ryan, in a field survey on September 8, 19 93, do hereby certify that under requirements of P.A. 74, Michigan P.A. of 1970, the corner points mentioned in lines 1 and 2 above were in conformance with regulations and rules therefore as required in the current manual of survey instructions of the United States Department of the Interior, Bureau of Land Management or by a decree of a Court of Law and/or that the corner points mentioned in lines 3, 4 and 5 above were in conformance with the rules of the Michigan Board of Land Surveyors or by a Decree of a Court of Law; established, re-established, monumented, re-monumented, recovered, found as expressed below:

	A	B	C	D	E	F	G	H	I	J	K	L	M
2	6	5	4	3	2	1							
3													
4	7	8	9	10	11	12							
5													
6	18	17	16	15	14	13							
7													
8	19	20	21	22	23	24							
9													
10	30	29	28	27	26	25							
11													
12	31	32	33	34	35	36							
13													

NOTE: Not more than 4 corners, all in the same town and range, may be recorded on this certificate.

A. Description of original monument and accessories and/or subsequent restoration:

GL0: 12" White Oak, S21°E, 63 links Heath, 1903: Stake & Stone
8" Hickory, N61°E, 63 links 16" Sugar Maple, N14½°E, 76½ links
24" Black Oak, S89 ¾°E, 192½ links

J Davis, 11/12/63: ½" Pipe in intersection of Keyes Road & M-66
32" Maple, N30°E, 51.19 feet
25" Maple, East, 35.41 feet
12" Basswood, S70°W, 63.29 feet

B. Description of corner evidence found and/or method applied in restoring or reestablishing corner:

Found ½" iron in monument box
2 feet, more or less, East of centerline of M-66.


SURVEY &
REMONUMENTATION.

APR 05 1994

COMMISSION

C. Description of monument for corner and accessories established to perpetuate locating the position of the corner:

Found ½" iron in monument box, replaced with Barry County Remonumentation iron & cap
Chiseled "X" with drill hole in top of concrete curb, N45°W, 53.40 feet
Chiseled "X" with drill hole in top of concrete curb, S45°W, 46.10 feet
P.K. in North side of Utility pole, S81°E, 67.63 feet
60p nail in Southwest side of 6" Elm, S45°E, 77.80 feet

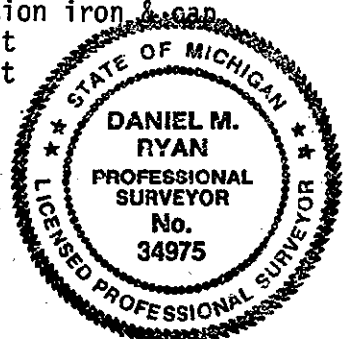

Signed by [Signature] Date September 8, 1993
Surveyor's Michigan License No. 34975