

SURVEY & REMONUMENTATION

FEB 17 1998

SECTION

**BARRY COUNTY REMONUMENTATION
LAND CORNER RECORDATION CERTIFICATE
Filing Requirement of Act 74, Mich. P.A. 1970**

For corners in

BARRY

(County)

ASSYRIA TOWNSHIP

Located In:

Cor



2647

Page: 1 of 1
12/16/1997 12:20P

Sandy Schonhelmayer - Barry Co. LCRCR

1. Public Land Survey T 1N R 7W G-13
 T _____ R _____
 T _____ R _____
 T _____ R _____
 2. Property Controlling S _____ T _____ R _____
 in Section S _____ T _____ R _____
 3. Miscellaneous S _____ T _____ R _____
 Property in Sec. S _____ T _____ R _____

Register of Deeds Stamp & File Number

4. Lot No. _____, Recorded Plat _____
 5. Private Claims _____

I, Robert R. CARR, in a field survey on APRIL 5, 1997 do hereby state that under requirements of P.A. 74, Michigan P.A. of 1970, the corner points mentioned in lines 1 and 2 above were in conformance with regulations and rules therefore as required in the current manual of survey instructions of the United States Department of the Interior, Bureau of Land Management or by a decree of a Court of Law and /or that the corner points mentioned in lines 3, 4 and 5 above were in conformance with the rules of the Michigan Board of Land Surveyors or by a Decree of a Court of Law; established, re-established, monumented, recovered, found as expressed below:

	A	B	C	D	E	F	G	H	I	J	K	L	M
1													
2		6		5		4		3		2		1	
3													
4		7		8		9		10		11		12	
5													
6		18		17		16		15		14		13	
7													
8		19		20		21		22		23		24	
9													
10		30		29		28		27		26		25	
11													
12		31		32		33		34		35		36	
13													

NOTE: Not more than 2 corners, all in the same town and range, may be recorded on this certificate.

A. Description of original monument and accessories and/or subsequent restoration:

G.L.O. MULLET D.S. 1825
 W. OAK 14, N80°E 2.04; DO 8, N8°W 1.00
 D. HOOTH 4-16-64 MICHIGAN STATE HIGHWAY DEPARTMENT, SET 1/2" PIPE
 N03°E 29.56 18" OAK; N35°W 34.38 18" OAK; S16°W 26.63 WOODEN FENCE POST
 BARRY COUNTY ROAD COMMISSION 1972 IRON WITH SAME WITNESSES AS D. HOOTH 1964
 L.C.R.C. NO. 57, 1972 SAME WITNESSES TO 1-1/2" PIPE


B. Description of corner evidence found and/or method applied in restoring or reestablishing corner:

FOUND SHORT 3/4" PIPE OVER 1-1/2" PIPE, ONE WITNESS STANDING (30" OAK, N03°E 30.17' TO CENTER) TREE ROW OCCUPATION TO NORTH ACCEPTED THIS LOCATION AS BEST EVIDENCE OF THE CORNER AND SET BARRY COUNTY REMONUMENTATION STAKE AND CAP IN CENTER OF 1-1/2" PIPE IN MONUMENT BOX.

ACT 345 BARRY COUNTY REMONUMENTATION
 APPROVED BY PEER REVIEW AT A MEETING HELD ON
8 Sept. '97 BR
 BRIAN REYNOLDS COUNTY SURVEYOR

C. Description of monument for corner and accessories established to perpetuate locating the position of the corner:

BARRY COUNTY REMONUMENTATION STAKE AND CAP IN MONUMENT BOX
 30" OAK, N57°E 54.65' SET SPOTTER
 30" OAK, N03°E 30.17' SET SPOTTER
 NORTHWEST CORNER CONCRETE BLOCK FOUNDATION OF GARAGE, S25°E 90.20'
 NORTHWEST CORNER HOUSE FOUNDATION, S56°E 113.91'
 CENTERLINE OF BITUMINOUS ROAD SOUTH 1' ±.

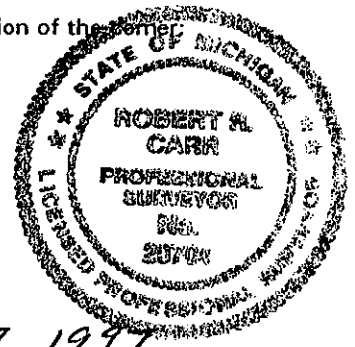

Signed by Robert R. Carr
 Surveyor's Michigan License No. 20704

Date Nov. 7, 1997