

**SURVEY & REMONUMENTATION**

FEB 17 1998

**SECTION**

**BARRY COUNTY REMONUMENTATION  
LAND CORNER RECORDATION CERTIFICATE  
Filing Requirement of Act 74, Mich. P.A. 1970**

For corners in

BARRY  
(County)

Located In:

Cor



**2648**

Page: 1 of 1  
12/16/1997 12:20P

Sandy Schondelmayer - Barry Co. LCRCR

ASSYRIA TOWNSHIP  
1. Public Land Survey

T 1N R 7W H-13

T \_\_\_\_\_ R \_\_\_\_\_ \_\_\_\_\_

T \_\_\_\_\_ R \_\_\_\_\_ \_\_\_\_\_

T \_\_\_\_\_ R \_\_\_\_\_ \_\_\_\_\_

2. Property Controlling  
in Section

S \_\_\_\_\_ T \_\_\_\_\_ R \_\_\_\_\_ \_\_\_\_\_

S \_\_\_\_\_ T \_\_\_\_\_ R \_\_\_\_\_ \_\_\_\_\_

3. Miscellaneous  
Property in Sec.

S \_\_\_\_\_ T \_\_\_\_\_ R \_\_\_\_\_ \_\_\_\_\_

S \_\_\_\_\_ T \_\_\_\_\_ R \_\_\_\_\_ \_\_\_\_\_

Register of Deeds Stamp & File Number

4. Lot No. \_\_\_\_\_, Recorded Plat \_\_\_\_\_

5. Private Claims \_\_\_\_\_

I, ROBERT R. CARR, in a field survey on APRIL 5, 1997 do hereby state that under requirements of P.A. 74, Michigan P.A. of 1970, the corner points mentioned in lines 1 and 2 above were in conformance with regulations and rules therefore as required in the current manual of survey instructions of the United States Department of the Interior, Bureau of Land Management or by a decree of a Court of Law and /or that the corner points mentioned in lines 3, 4 and 5 above were in conformance with the rules of the Michigan Board of Land Surveyors or by a Decree of a Court of Law; established, re-established, monumented, recovered, found as expressed below:

**NOTE: Not more than 2 corners, all in the same town and range, may be recorded on this certificate.**

A. Description of original monument and accessories and/or subsequent restoration:

G.L.O. MULLET 1825, W.O. 12 N25 1/2 E 19; DO 9 N53 1/2 W 75  
D HOOTH 4-16-64 MICHIGAN STATE HIGHWAY DEPARTMENT SET 1-1/2" IRON PIPE  
N45°W 28.55 20"OAK; N55°E 33.55 32" OAK; S45°E 44.90 P.P.  
BARRY COUNTY ROAD COMMISSION 1972 SAME WITNESSES  
L.C.R.C. NO. 52 SAME WITNESSES  
DON WOLF, BARRY COUNTY ROAD COMMISSION 1996 SET MONUMENT BOX

	A	B	C	D	E	F	G	H	I	J	K	L	M
1													
2	6		5		4		3		2				1
3													
4	7		8		9		10		11				12
5													
6	18		17		16		15		14				13
7													
8	19		20		21		22		23				24
9													
10	30		29		28		27		26				25
11													
12	31		32		33		34		35				36
13													


B. Description of corner evidence found and/or method applied in restoring or reestablishing corner:

FOUND 1-1/2" IRON PIPE IN MONUMENT BOX WITH TWO HOOTH 1964 WITNESSES REMAINING.  
ACCEPTED THIS LOCATION AS BEST EVIDENCE OF CORNER AND SET BARRY COUNTY REMONUMENTATION  
STAKE AND CAP IN MONUMENT BOX.

ACT 345 BARRY COUNTY REMONUMENTATION  
APPROVED BY PEER REVIEW AT A MEETING HELD ON  
8 SEPT 97 BR  
BRIAN REYNOLDS COUNTY SURVEYOR

C. Description of monument for corner and accessories established to perpetuate locating the position of the corner:

BARRY COUNTY REMONUMENTATION STAKE AND CAP IN MONUMRNT BOX  
UTILITY POLE, S49°E 45.10 FEET, SET SPOTTER  
48" OAK, N54°E 33.11 FEET, SET SPOTTER  
9" OAK, N55°W 48.60 FEET, SET SPOTTER  
28" ELM, N80°E 79.74 FEET, SET SPOTTER  
NORTHWEST CORNER OF HOUSE FOUNDATION, S32.5°E 156.55 FEET  
CENTERLINE OF ROAD SOUTH 1 FOOT MORE OR LESS,

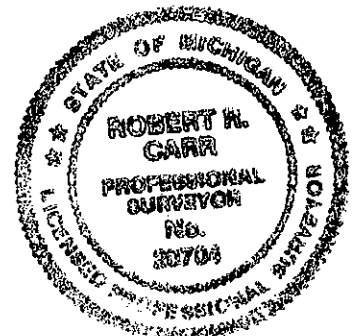

Signed by [Signature]  
Surveyor's Michigan License No. 20704

Date NOV. 7, 1997